IREDELL COUNTY HEALTH DEPARTMENT

SAGEFIELD II, LOT #31

STATESVILLE 704-878-5305 MOORESVILLE 704-664-5281

IMPROVEMENT PERMIT / AUTHORIZATION TO CONSTRUCT / OPERATION PERMIT / EXISTING SYSTEM INSPECTION

PERMIT# HARMONY PIN# 4870 68 9069 DATE 8-1-98

OWNER OR CONTRACTOR HARMONY PROPERTIES PHONE: Business Home 532-6625

ADDRESS 5551 MONROE ROAD, CHARLOTTE, NC 28212

LOCATION US 21 N, TR HIGHLAND POINT AV, TR REDMON, TR PEPPERTREE, TR CEDARVALE DRIVE, 9TH LOT ON RIGHT

SUBDIVISION SAGEFIELD BLOCK / SECTION II LOT 31 LOT AREA 1.038 ACRES SITE CLASS PS DESIGN FLOW 360 L.T.A.R. 0.30 GPD/FT²

Septic Tank: 1000 Gallons; STB 821 Date 7-11-98

Pump Tank: 1000 Gallons; PT 40 Date 7-1-98

Pump Make: ZOELLER Model N96-B Serial No.

Nitrification Field: No Fields 1 Square Feet 1200 Linear Feet 400

No Lines FOUR Trench Width 36" Max Trench Bottom Depth 28" Gravel Depth 12"

☑ New System ☐ Repair System Type: I, II, III, IV, V, VI

System Description: CONVENTIONAL, PUMP

Repair System Description: LOW PRESSURE PIPE

Maintenance Agreement Required: ☐ Yes ☑ No

☐ House/Mod. Home ☑ Mobile Home ☐ Business ☐ Other

No. Bedrooms 3 No. Bathrooms 2 No. Employees


☐ Slab ☑ Crawl Space ☐ Basement w/plumbing ☐ Basement wo/plumbing

Water Supply: ☐ Individual ☑ Public ☐ Community

Comments:/Conditions: SEE ATTACHED SHEETS FOR PUMP AND PRESSURE MANIFOLD REQUIREMENTS

Comments:/Conditions:

INITIAL SITE SKETCH SCALE: 1" = 50'

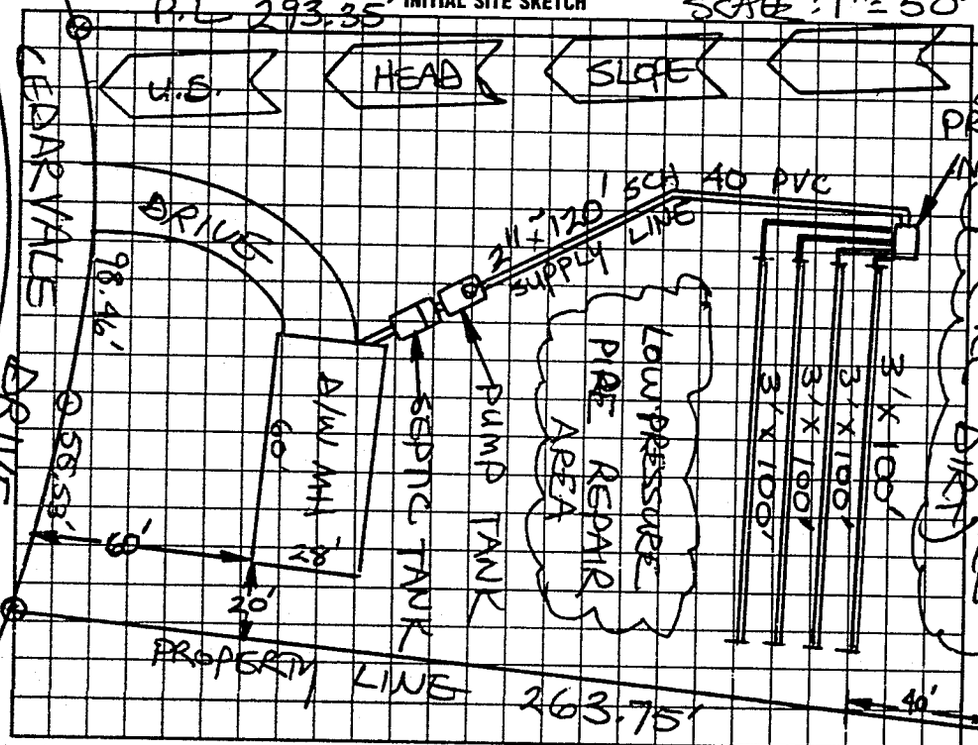

AS BUILT SKETCH

SYSTEM INSTALLED ACCORDING TO INITIAL SITE SKETCH

I understand that this permit can be suspended or revoked if any false information is supplied toward securing the permit/any unauthorized changes are made to the site/any unauthorized changes are made in the installation of the system. Improvement Permit with plat valid without expiration. Improvement Permit with site plan valid for sixty months. Authorization to Construct is valid for a period equal to that of Improvement Permit – not to exceed sixty months.

Signed: James J. Bradley date 8-6-98

Improvement Permit by: STEVE HEDRICK date 8-1-98

Authorization to Construct by: STEVE HEDRICK date 8-1-98

Installed by: G & M ENTERPRISES

Operation Permit by: STEVE HEDRICK date 10-29-98

Existing System Inspection by date

HEALTH DEPT. COPY: WHITE INSPECTION COPY (FINAL): GREEN OWNER COPY (FINAL): YELLOW INSPECTION COPY (INITIAL): PINK OWNER COPY (INITIAL): GOLD