IREDELL COUNTY HEALTH DEPARTMENT

STATESVILLE 704-878-5305 MOORESVILLE 704-664-5281

IMPROVEMENT PERMIT / AUTHORIZATION TO CONSTRUCT / OPERATION PERMIT / EXISTING SYSTEM INSPECTION

PERMIT# HARMONY PIN# 4870 68 9616 DATE 4-3-01

OWNER OR CONTRACTOR ROBERT MESSICK PHONE: Business Home (336) 492-7873

ADDRESS 4155 HWY 64 MOCKSVILLE, NC 27028

LOCATION US 21 N, TR HIGHLAND POINT AVE, NEXT TO LAST LOT ON LEFT BEFORE CURVE

SUBDIVISION BLOCK / SECTION LOT 29,30,31 LOT AREA 150' x 250' 0.86 ACRE SITE CLASS PS DESIGN FLOW 360 L.T.A.R. 0.35 GAL/FT²

Septic Tank: 1000 Gallons; STB 620 Date 2-27-01
Pump Tank: Gallons; PT Date
Pump Make: Model Serial No
Nitrification Field: No Fields 1 Square Feet 1035 Linear Feet 345
No Lines FOUR Trench Width 36" Max Trench Bottom Depth 36" Gravel Depth 12"

☑ New System ☐ Repair System Type: I, II, III, IV, V, VI
System Description: CONVENTIONAL GRAVITY
Repair System Description: 25% REDUCTION PUMP
Maintenance Agreement Required: ☐ Yes ☐ No


☐ House/Mod. Home No. Bedrooms 3
☑ Mobile Home No. Bathrooms 2
☐ Business No. Employees
☐ Other
☐ Slab ☐ Crawl Space ☐ Basement w/plumbing ☐ Basement wo/plumbing

Water Supply: ☐ Individual ☑ Public ☐ Community

Comments/Conditions:

Comments/Conditions: SEPTIC TANK WITH RISERS INSTALLED USING "ZABEL" FILTER

INITIAL SITE SKETCH SCALE: 1"=50'

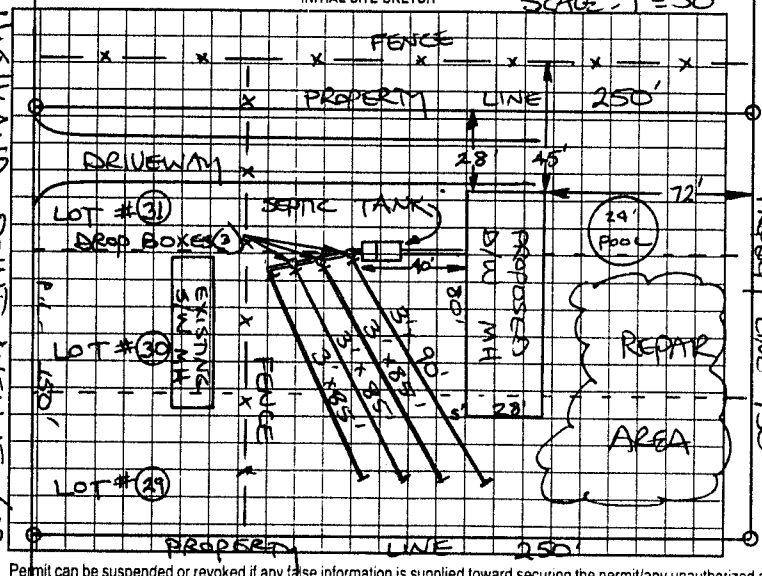

AS BUILT SKETCH

SYSTEM INSTALLED ACCORDING TO INITIAL SITE SKETCH

Permit can be suspended or revoked if any false information is supplied toward securing the permit/any unauthorized changes are made to the site/any unauthorized changes are made in the installation of the system. Improvement Permit with plat valid without expiration. Improvement Permit with site plan valid for sixty months. Authorization to Construct is valid for a period equal to that of Improvement Permit – not to exceed sixty months.

Signed: Robert W Messick date 4-3-01 Installed by: SAMMY REAVIS

Improvement Permit by: STEVE HEDRICK date 4-3-01 Operation Permit by: STEVE HEDRICK date 6-15-01

Authorization to Construct by: STEVE HEDRICK date 4-3-01 Existing System Inspection by: date

HEALTH DEPT. COPY: WHITE OWNER COPY (FINAL): YELLOW OWNER COPY (INITIAL): PINK