IREDELL COUNTY HEALTH DEPARTMENT

STATESVILLE 704-878-5305 MOORESVILLE 704-664-5281

IMPROVEMENT PERMIT / AUTHORIZATION TO CONSTRUCT / OPERATION PERMIT / EXISTING SYSTEM INSPECTION

PERMIT# Repair PIN# 4870-69-3129 DATE 11/6/03

OWNER OR CONTRACTOR Franklin Fink PHONE: Business — Home (704)546-2749

ADDRESS 135 Woodland Bend Drive ~~Statesville~~ Harmony N.C. 28634

LOCATION Hwy 21 N past Courtesy Light Hwy 901 (R) on Woodland Bend Drive on left @ 135 Woodland Bend Dr.

SUBDIVISION — BLOCK / SECTION — LOT — LOT AREA 0.75 Ac. SITE CLASS. 45 DESIGN FLOW Ex (600) L.T.A.R. —

Septic Tank: 1500 Gallons; STB 934 Date 10-3-03
Pump Tank: — Gallons; PT — Date —
Pump Make: — Model — Serial No. —
Nitrification Field: No Fields Ex Square Feet Ex Linear Feet Ex
No Lines Ex Trench Width — Max Trench Bottom Depth — Gravel Depth —

☐ New System ☒ Repair System Type: ☒ I ☐ II, III, IV, V, VI
System Description: Gravity Conv.
Repair System Description: —
Maintenance Agreement Required: ☐ Yes ☒ No


☒ House/Mod. Home No. Bedrooms 5
☐ Mobile Home No. Bathrooms 2½
☐ Business No. Employees —
☐ Other Partial
☐ Slab ☐ Crawl Space ☐ Basement w/plumbing ☒ Basement wo/plumbing

Water Supply: ☐ Individual ☒ Public ☐ Community


Comments:/Conditions: ① Pump out o/s Septic Tank Crush + fill o/s Tank ② Set New Septic Tank (1500 gal new size) + Connect to existing lines. ③ Replace Pool box if needed ④ This permit Serves as Notice of Violation (NOV) 30 days to complete this repair.

Comments:/Conditions:

INITIAL SITE SKETCH

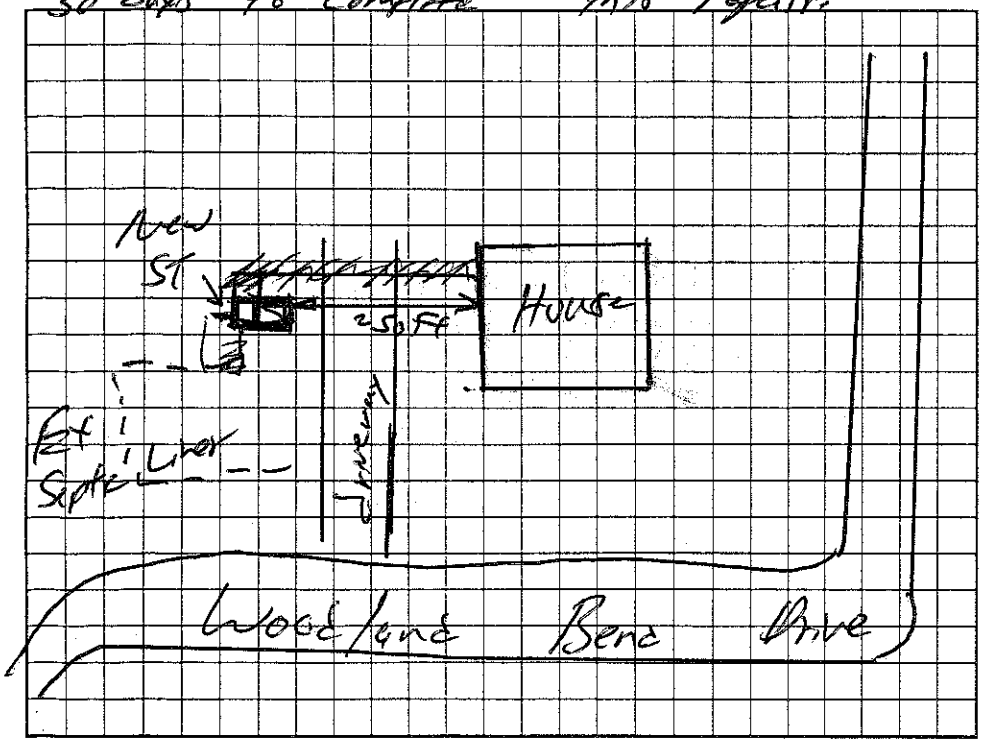

AS BUILT SKETCH

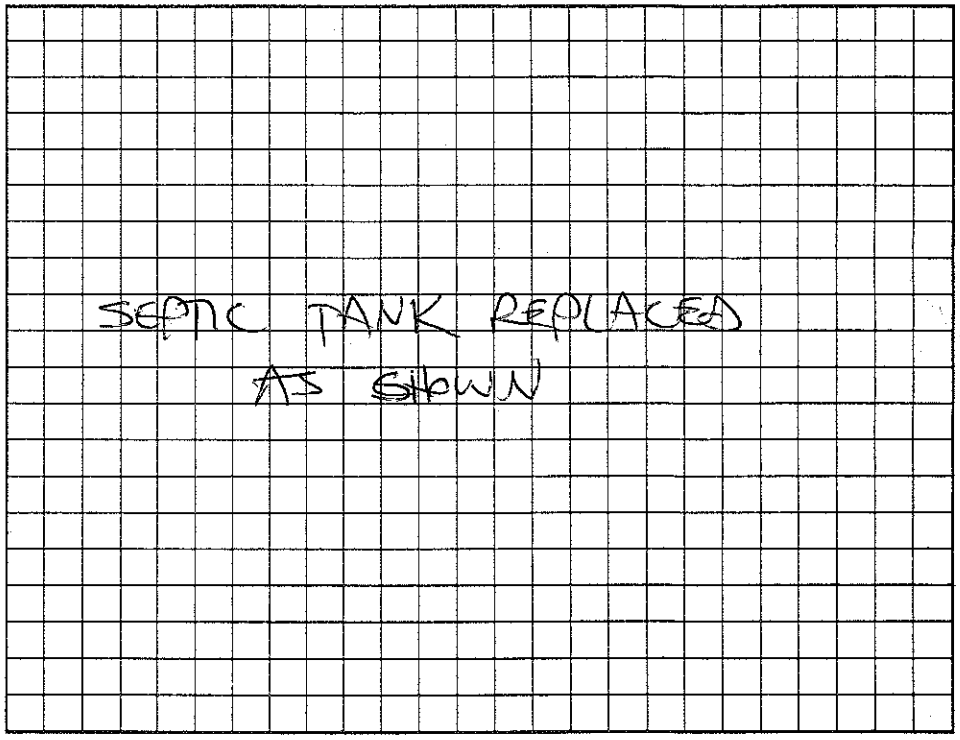

Permit can be suspended or revoked if any false information is supplied toward securing the permit/any unauthorized changes are made to the site/any unauthorized changes are made in the installation of the system. Improvement Permit with plat valid without expiration. Improvement Permit with site plan valid for sixty months. Authorization to Construct is valid for a period equal to that of Improvement Permit – not to exceed sixty months.

Signed: Franklin Fink date —

Improvement Permit by: William C. Johnson date 11/6/03

Authorization to Construct by: William C. Johnson date 11/6/03

Installed by: SAMMY REAVIS

Operation Permit by: STEVE HENDRICK date 12-19-03

Existing System Inspection by: — date —

HEALTH DEPT. COPY: WHITE OWNER COPY (FINAL): YELLOW OWNER COPY (INITIAL): PINK