IREDELL COUNTY HEALTH DEPARTMENT

STATESVILLE 704-878-5305 MOORESVILLE 704-664-5281

IMPROVEMENT PERMIT / AUTHORIZATION TO CONSTRUCT / OPERATION PERMIT / EXISTING SYSTEM INSPECTION

PERMIT# 148854 PIN# 4870738863 DATE 3-19-08

OWNER OR APPLICANT Joseph - Sue Ann Cranfill PHONE: Business ____ Home 704-546-2094

ADDRESS 503 Cranfill Rd Harmony 28634

LOCATION Hwy 21 N E. Memorial Hwy 28634

SUBDIVISION ____ BLOCK / SECTION ____ LOT ____ LOT AREA 15,998 SITE CLASS. PS DESIGN FLOW 480 L.T.A.R. .25

Septic Tank: 1000 Gallons; STB ____ Date ____

Pump Tank: ____ Gallons; PT ____ Date ____

Pump Make: ____ Model ____ Serial No. ____

Nitrification Field: No Fields ____ Square Feet 1920 Linear Feet 480

No Lines 5 Trench Width 36" Max Trench Bottom Depth 36" Gravel Depth ____

☑ New System ☐ Repair ☐ Expansion System Type: (II) III IV V VI

System Description: 25% Gravity

Repair System Description: 25% Pump

Maintenance Agreement Required: ☐ Yes ☐ No

☑ Gravity ☐ Pressure

☑ House/Mod. Home ☐ Mobile Home ☐ Business ☐ Other ____

No. Bedrooms 4 No. Persons ____ No. Employees ____


Water Supply: ☐ Individual ☑ Public ☐ Community

☐ Slab ☐ Crawl Space ☑ Basement w/plumbing ☐ Basement wo/plumbing


Comments:/Conditions:

Comments:/Conditions: Install on Contour Maintain all setbacks

INITIAL SITE SKETCH

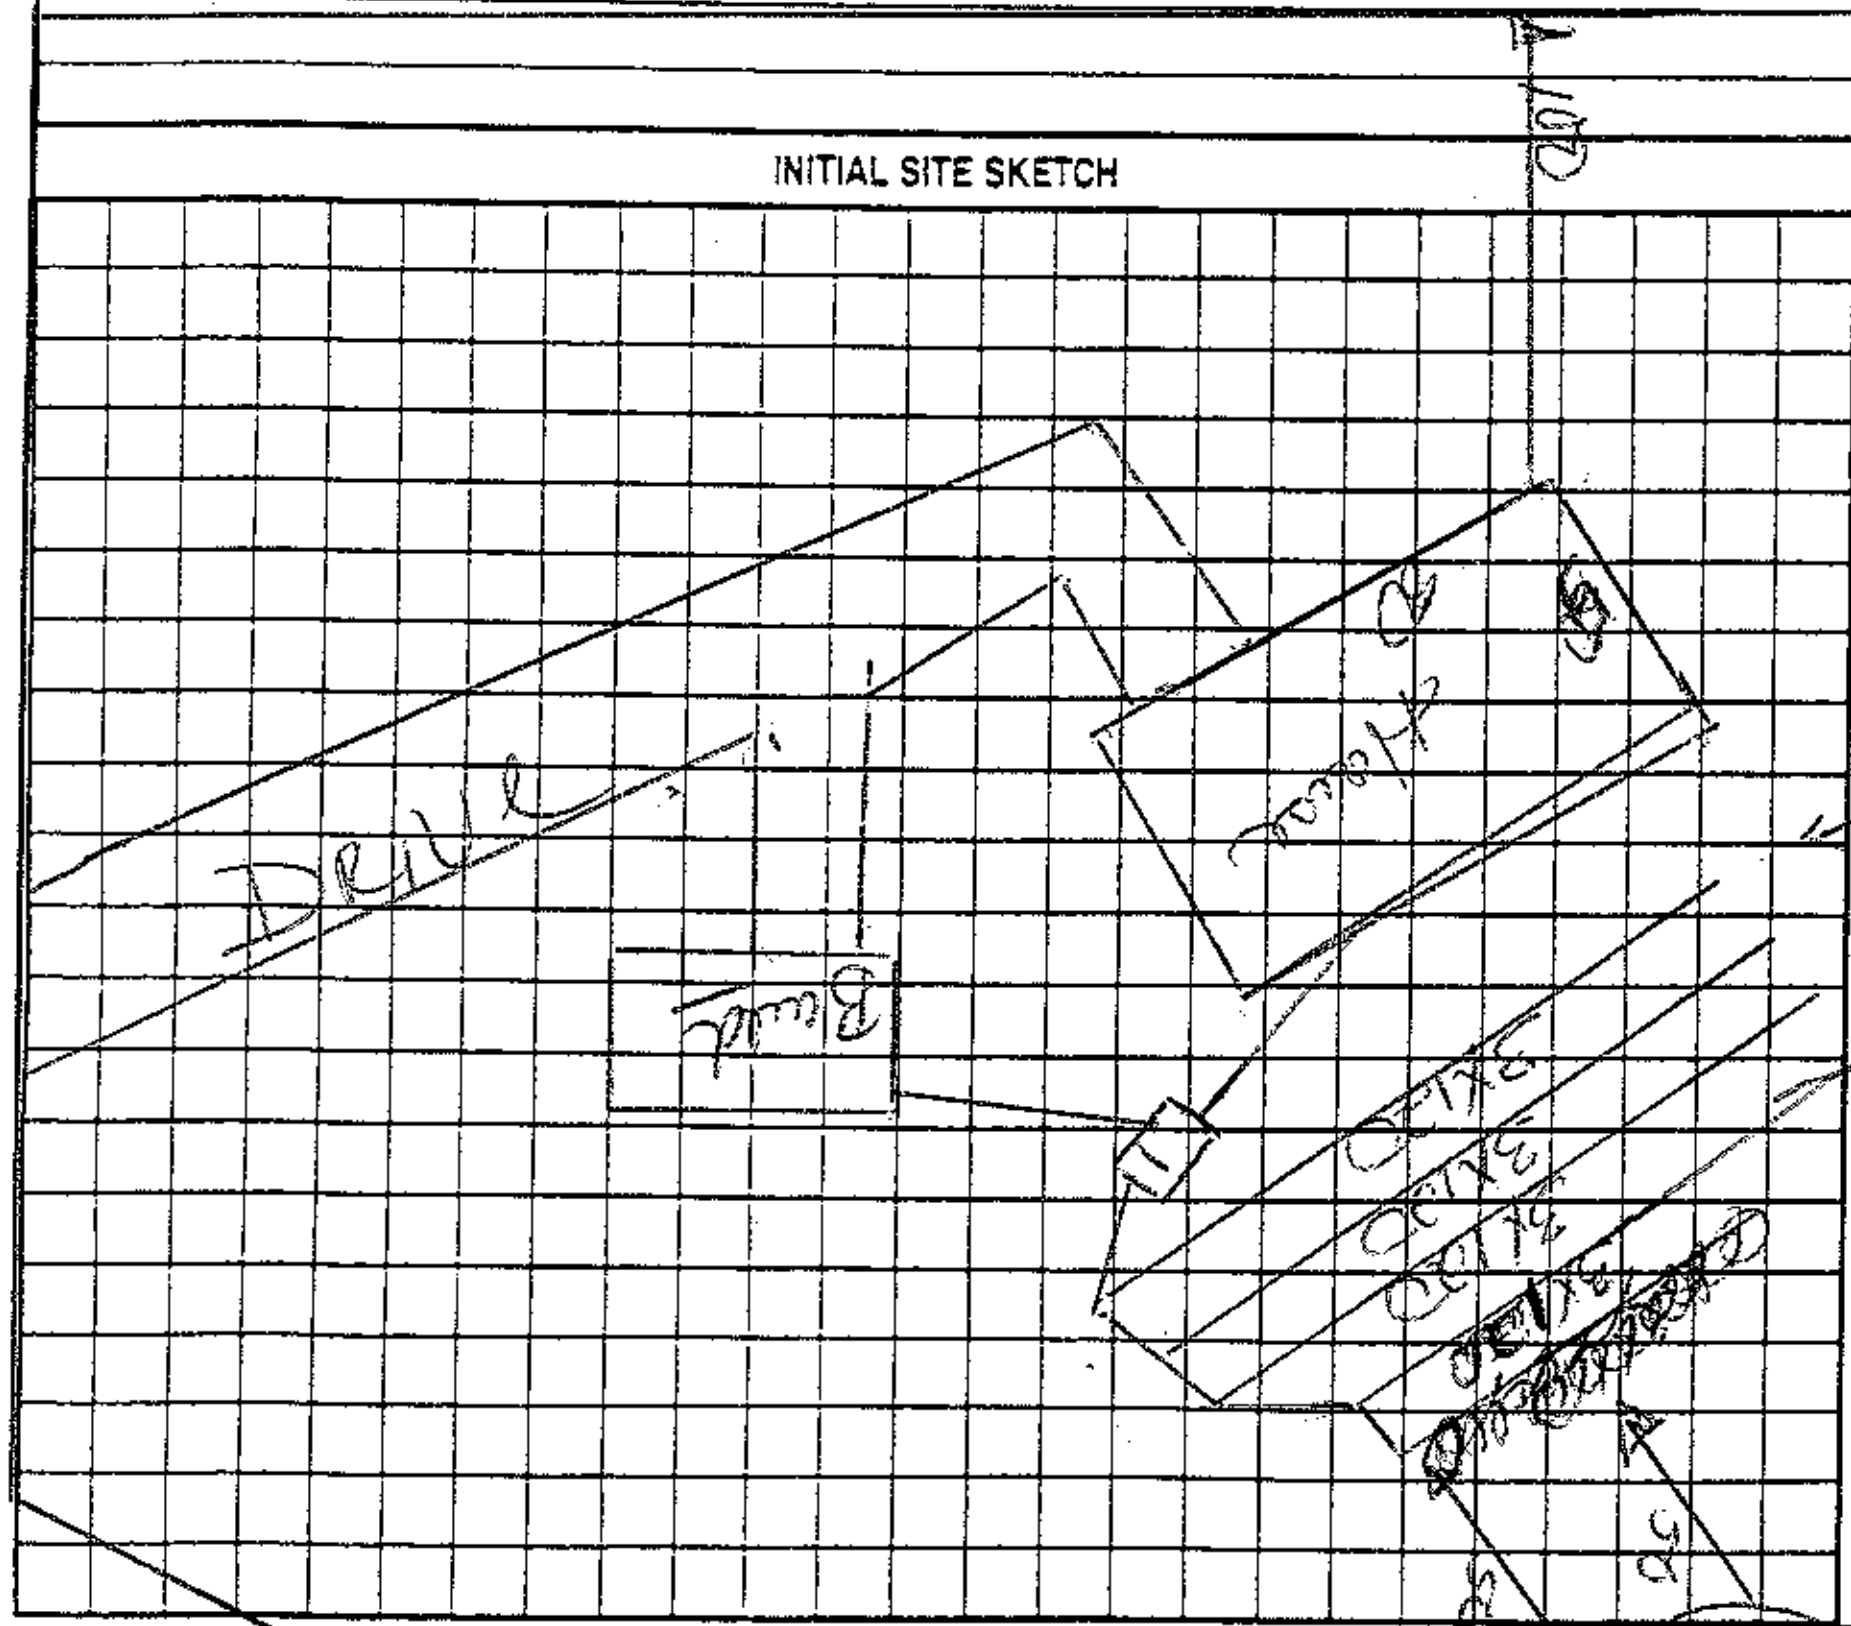

AS BUILT SKETCH

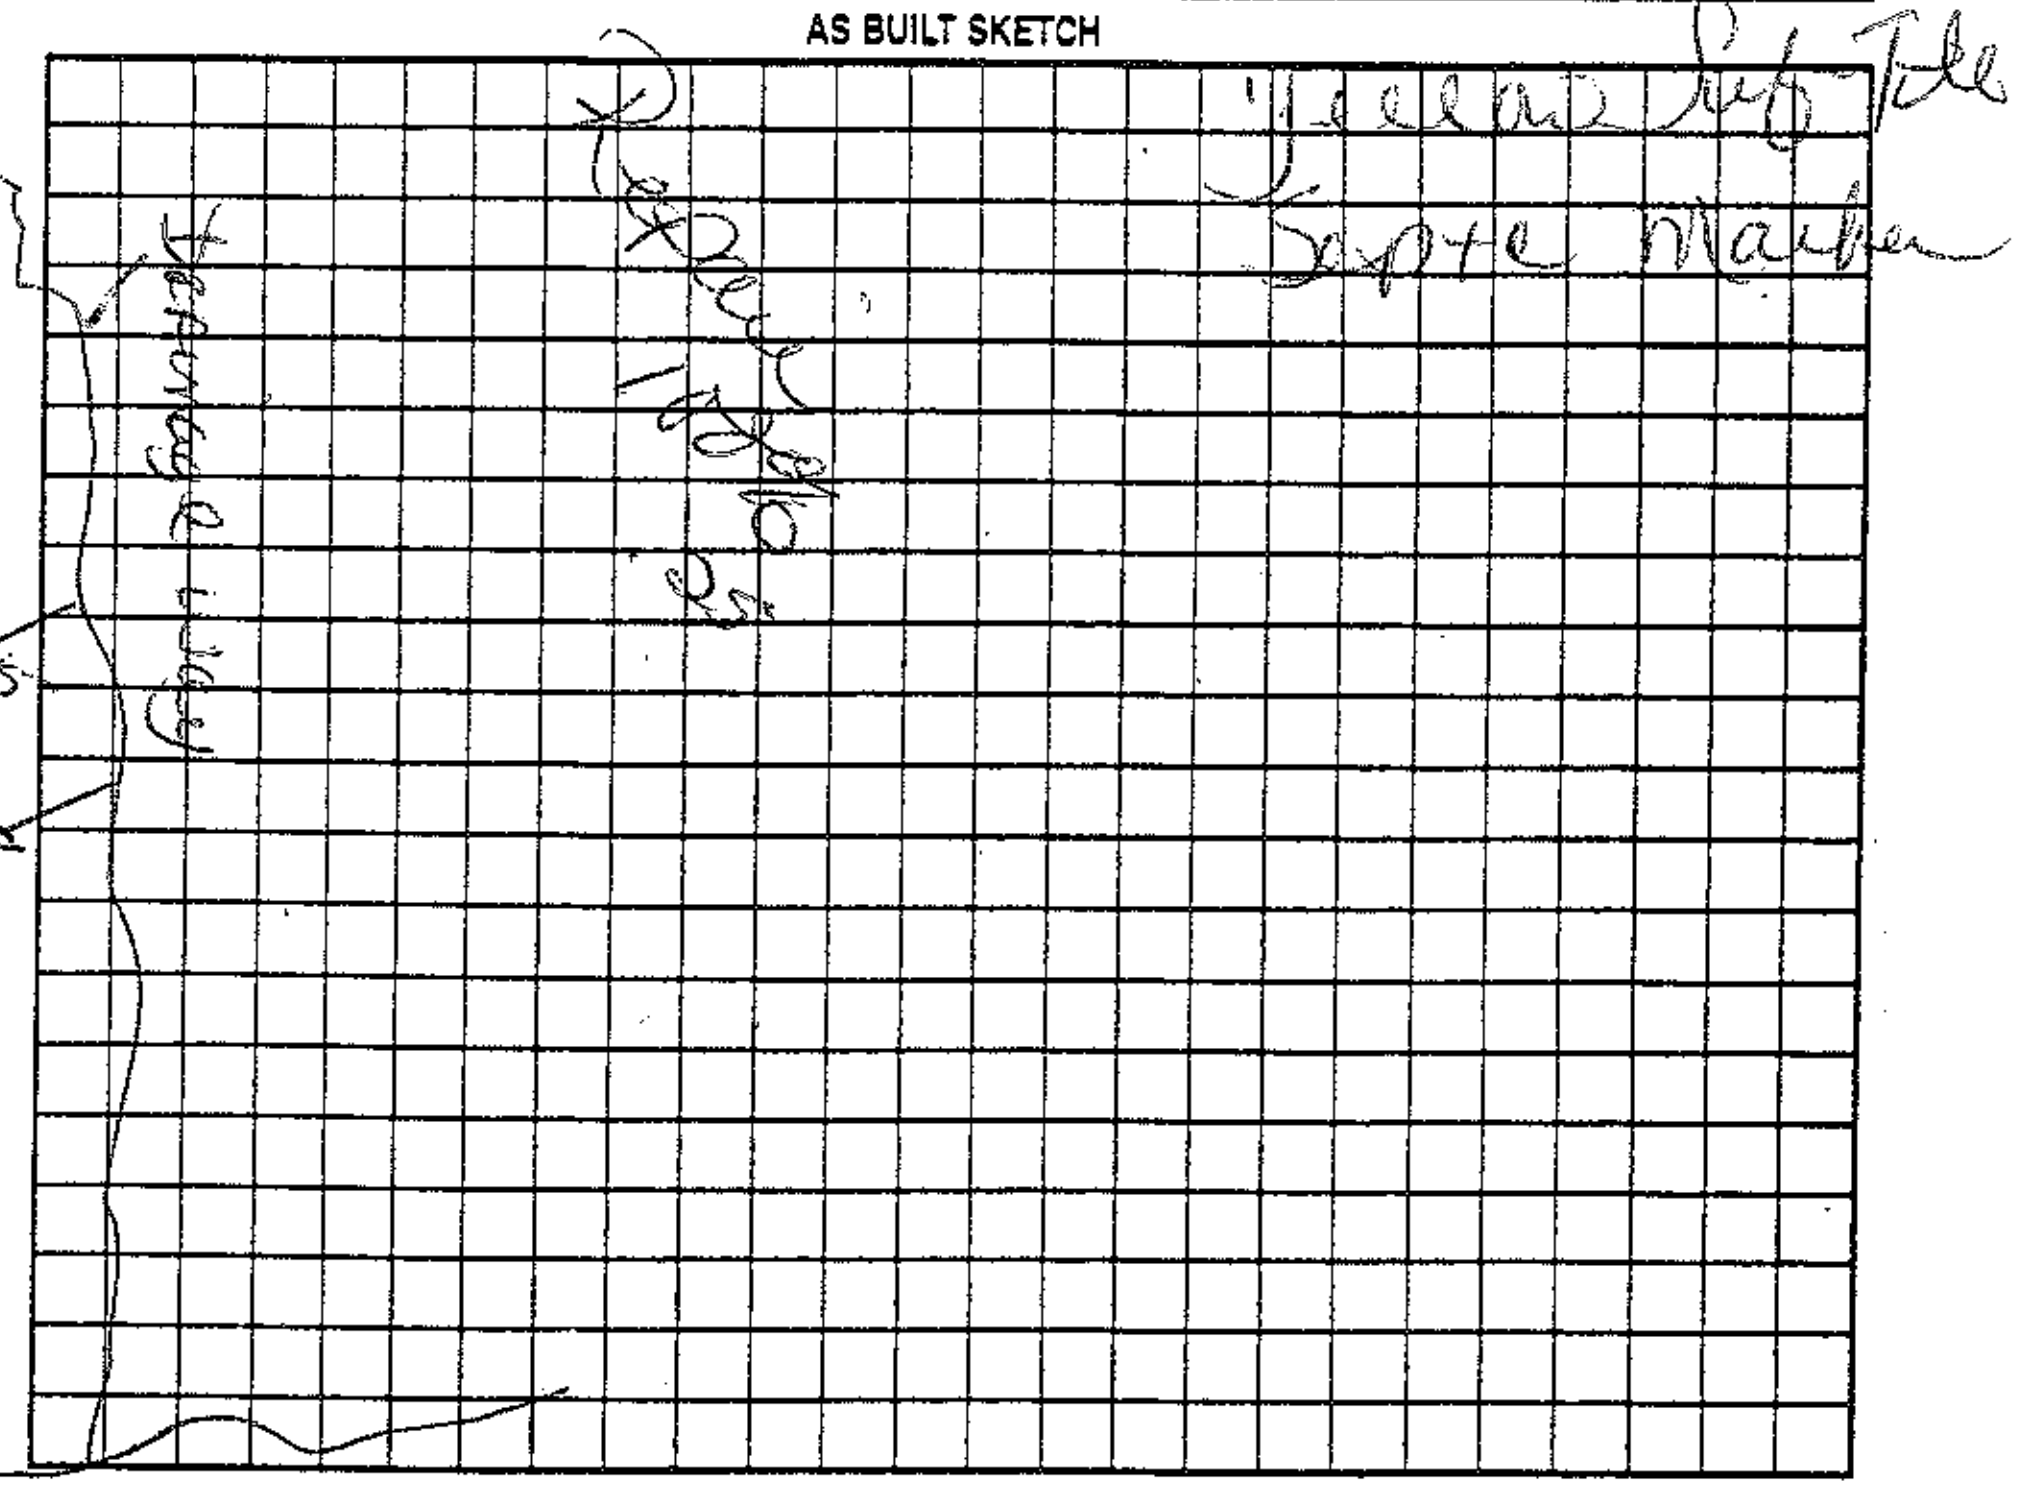

Cranfield

Permit can be suspended or revoked if any false information is supplied toward securing the permit/any unauthorized changes are made to the site/any unauthorized changes are made in the installation of the system. Improvement Permit with plat valid without expiration ☐ Improvement Permit with site plan valid for sixty months ☑ Authorization to Construct is valid for a period equal to that of Improvement Permit – not to exceed sixty months.

Signed: [signature] date ____

Improvement Permit by: Kelly Cook date 3-19-08

Authorization to Construct by: Kelly Cook date 3-19-08

Installed by: Tommy Frye

Operation Permit by: Kelly Cook date 8-15-08

Existing System Inspection by: ____ date ____

HEALTH DEPT. COPY: WHITE OWNER COPY (FINAL): YELLOW OWNER COPY (INITIAL): PINK