IREDELL COUNTY HEALTH DEPARTMENT

STATESVILLE 704-878-5305 MOORESVILLE 704-664-5281

IMPROVEMENT PERMIT / AUTHORIZATION TO CONSTRUCT / OPERATION PERMIT / EXISTING SYSTEM INSPECTION

PERMIT# 089794 PIN# 4870 74 5786 DATE 6-16-2000

OWNER OR CONTRACTOR CHARLES L. JOHNSON PHONE Business Home (336) 468-4832

ADDRESS 3041 SPANN ROAD, HAMPTONVILLE NC 27020

LOCATION US 21 NORTH, TR NC901, TR CRANFILL ROAD, 0.3 MILE ON LEFT

SUBDIVISION BLOCK / SECTION LOT LOT AREA 0.70 ACRE SITE CLASS PS DESIGN FLOW 360 L.T.A.R. 0.30 GPD/FT2

Septic Tank: 1000 Gallons; STB 620 Date 5-16-00
Pump Tank: Gallons; PT Date
Pump Make: Model Serial No
Nitrification Field: No Fields 1 Square Feet 1200 Linear Feet 400
No Lines SIX Trench Width 36" Max Trench Bottom Depth 36" Gravel Depth 12"

☑ New System ☐ Repair System Type: I II III IV V VI
System Description: CONVENTIONAL GRAVITY
Repair System Description: CONVENTIONAL PUMP
Maintenance Agreement Required ☐ Yes ☑ No

☐ House/Mod Home ☑ Mobile Home ☐ Business ☐ Other
No. Bedrooms 3 No. Bathrooms 2 No. Employees


☐ Slab ☑ Crawl Space ☐ Basement w/plumbing ☐ Basement wo/plumbing

Water Supply: ☐ Individual ☑ Public ☐ Community

Comments/Conditions: ① KEEP SYSTEM MINIMUM TEN (10) FEET FROM WATER LINE ② USE ONE FLOW DIVIDER TEE TO ACHIEVE EQUAL DISTRIBUTION INTO TWO DIST. BOXES FEEDING THREE LINES EACH.

Comments/Conditions: SEPTIC TANK W/ RISERS INSTALLED USING "THETITE" FILTER

INITIAL SITE SKETCH

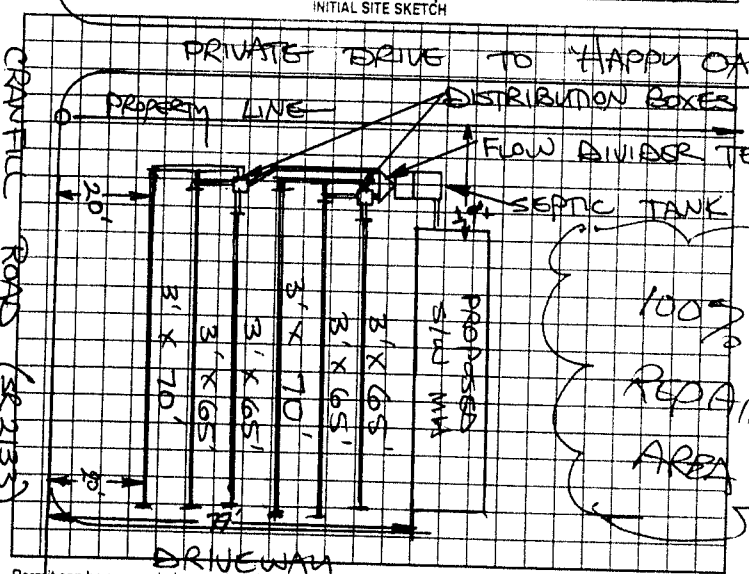

AS BUILT SKETCH

SEPTIC TANK SYSTEM INSTALLED ACCORDING TO INITIAL SITE SKETCH

Permit can be suspended or revoked if any false information is supplied toward securing the permit; any unauthorized changes are made to the site; any unauthorized changes are made in the installation of the system. Improvement Permit with plat valid without expiration. Improvement Permit with site plan valid for sixty months. Authorization to Construct is valid for a period equal to that of Improvement Permit - not to exceed sixty months.

Signed: Sammy Johnson date 6-16-00 Installed by: SAMMY BEAULS

Improvement Permit by: STEVE HEDRICK date 6-16-2000 Operation Permit by: STEVE HEDRICK date 7-17-2000

Authorization to Construct by: STEVE HEDRICK date 6-16-2000 Existing System Inspection by: date

HEALTH DEPT. COPY: WHITE OWNER COPY (FINAL): YELLOW OWNER COPY (INITIAL): PINK