IREDELL COUNTY HEALTH DEPARTMENT

STATESVILLE 704-878-5305 MOORESVILLE 704-664-5281

IMPROVEMENT PERMIT / AUTHORIZATION TO CONSTRUCT / OPERATION PERMIT / EXISTING SYSTEM INSPECTION

PERMIT# REPAIR PIN# 4870-74-6614 DATE 5-9-06

OWNER OR APPLICANT CHARLES LARRY JOHNSON PHONE: Business 704-539-4919 Home

ADDRESS 3041 SPANN RD. HAMPTONVILLE NC 27020-7222

LOCATION US 21 NORTH, TR NC 901 TR CRANFILL ROAD, 0.3 MILE ON LEFT AT #544

SUBDIVISION BLOCK / SECTION LOT LOT AREA 0.73 ACRE SITE CLASS PS DESIGN FLOW 360 L.T.A.R. @ 30 GPD/FT²

Septic Tank: EXISTING Gallons; STB Date

Pump Tank: Gallons; PT Date

Pump Make: Model Eq. PP Serial No.

Nitrification Field: No Fields 1 Square Feet 240 Linear Feet 60

No Lines ONE Trench Width 36" Max Trench Bottom Depth 36" +/- Gravel Depth N/A

☐ New System ☑ Repair ☐ Expansion System Type: I II III IV V VI

System Description:

Repair System Description:

Maintenance Agreement Required: ☐ Yes ☐ No

☑ House/Mod. Home No. Bedrooms 3

☐ Mobile Home No. Persons

☐ Business No. Employees

☐ Other


Water Supply: ☐ Individual ☑ Public ☐ Community

☐ Gravity ☐ Pressure ☐ Slab ☐ Crawl Space ☐ Basement w/plumbing ☐ Basement wo/plumbing


Comments:/Conditions: REPLACE EXISTING SECTION OF DRAINLINE (CEMENT TILE) WITH NEW 3'X 60' DRAINLINE USING 25% REDUCTION SYSTEM.

Comments:/Conditions:

INITIAL SITE SKETCH

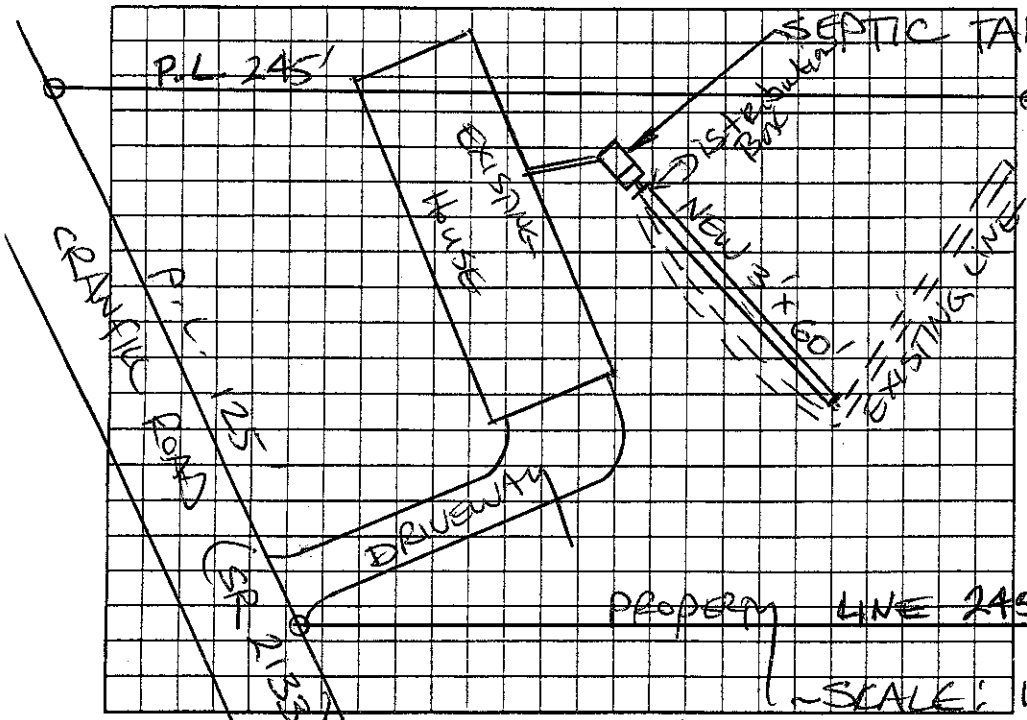

AS BUILT SKETCH

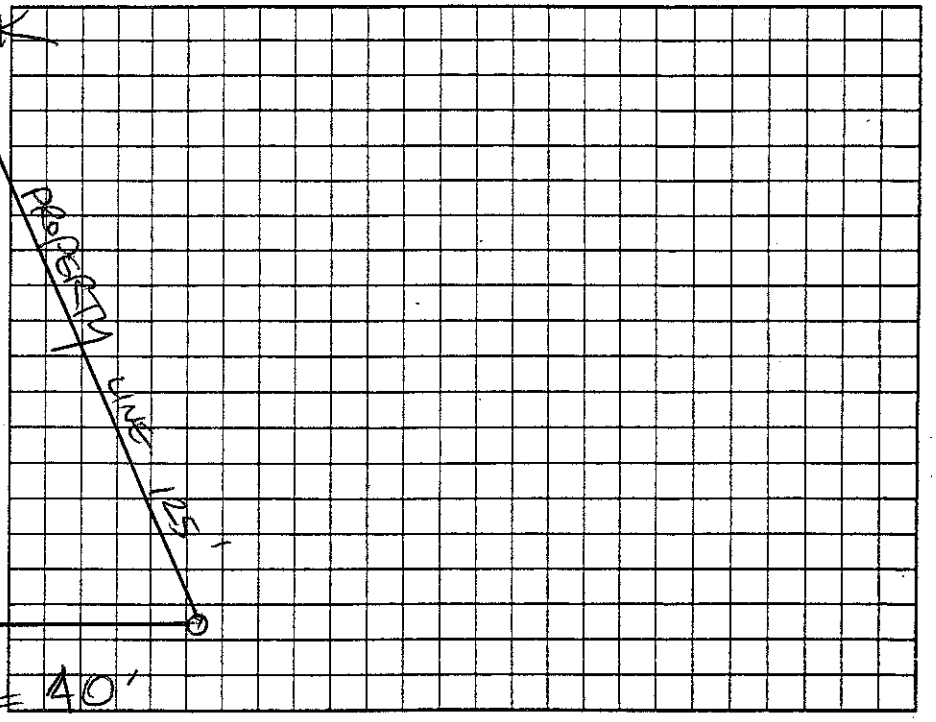

Permit can be suspended or revoked if any false information is supplied toward securing the permit/any unauthorized changes are made to the site/any unauthorized changes are made in the installation of the system. Improvement Permit with plat valid without expiration. ☐ Improvement Permit with site plan valid for sixty months ☑ Authorization to Construct is valid for a period equal to that of Improvement Permit – not to exceed sixty months.

Signed: Crystal Shoemaker date 5-10-06 Installed by: David Lentz

Improvement Permit by: STEVE HEDRICK date 5-9-06 Operation Permit by: Kelly Cook date 6-1-06

Authorization to Construct by: STEVE HEDRICK date 5-9-06 Existing System Inspection by: date

HEALTH DEPT. COPY: WHITE OWNER COPY (FINAL): YELLOW OWNER COPY (INITIAL): PINK