Void Permit date 6-25-97

# IREDELL COUNTY HEALTH DEPARTMENT

STATESVILLE 704-878-5305 MOORESVILLE 704-664-5281

## IMPROVEMENT PERMIT / CERTIFICATE OF COMPLETION / OPERATION PERMIT / EXISTING SYSTEM INSPECTION

PROPERTY DESCRIPTION NO. 067597 DATE 7-7-97 TAX MAP NO. 4870754907 Watershed: ☐ Yes ☐ No

OWNER OR CONTRACTOR Billy E Gaither PHONE: Business _____ Home _____

ADDRESS 212 Emergency Hwy Harmony NC

LOCATION 21N TR 901 TR Crankill 1st lot on left

SUBDIVISION _____ BLOCK / SECTION _____ LOT _____ LOT AREA _____ SITE CLASS. P/S DESIGN FLOW 360 L.T.A.R. 0.3

Septic Tank: 1000 Gallons; STB _____ Date _____

Pump Tank: _____ Gallons; PT _____ Date _____

Pump Make: _____ Model _____ Serial No. _____

Nitrification Field: No Fields 1 Square Feet _____ Linear Feet 150

No Lines 1 Trench Width 30 in Max Trench Bottom Depth 36 in

☒ New System ☐ Repair System Type: I II III, IV, V, VI

System Description: Conventional Gravity

Repair System Description: _____

Maintenance Agreement Required: ☐ Yes ☒ No

Gravel Depth 12 in ☐ Slab ☐ Crawl Space ☐ Basement w/plumbing ☐ Basement wo/plumbing

☐ House/Mod. Home No. Bedrooms 3

☒ Mobile Home No. Bathrooms 2

☐ Business No. Employees _____


☐ Other _____

Water Supply: ☒ Individual ☐ Community ☐ Public


Comments: Changing from 2Bd to 3Bd. Check Tank - replace sanitary T' if needed. owell

Comments:

INITIAL SITE SKETCH

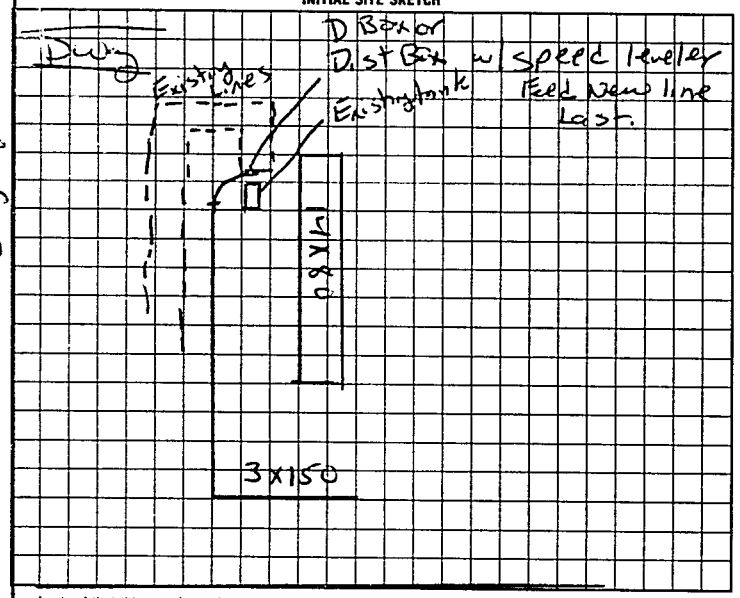


AS BUILT SKETCH

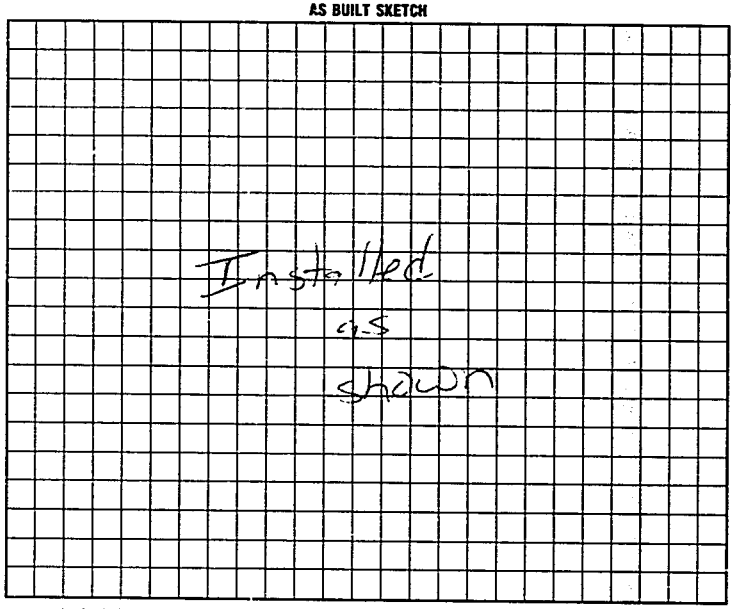


P21147

I understand that this permit can be suspended or revoked if any false information is supplied toward securing the permit/any unauthorized changes are made to the site/any unauthorized changes are made in the installation of the system. Improvement Permit is valid for 60 months from date of issuance. Authorization to Construct expires 5 yrs from issue date

Signed: Margaret Gaither

Improvement Permit by: Mark C Ost, RS date 7-7-97

~~Existing System Inspection by:~~ Authorization to Const. Mark C Ost, RS date 7-7-97

Installed by: Tommy Frye

Certificate of Completion by: _____ date _____

Operation Permit by: Mark C Ost, RS date 8-1-97

HEALTH DEPT COPY: WHITE INSPECTION COPY (FINAL): GREEN OWNER COPY (FINAL): YELLOW INSPECTION COPY (INITIAL): PINK OWNER COPY (INITIAL): GOLD

8 1 9 0 0 0