IREDELL COUNTY HEALTH DEPARTMENT

STATESVILLE 704-878-5305 MOORESVILLE 704-664-5281

IMPROVEMENT PERMIT / CERTIFICATE OF COMPLETION / OPERATION PERMIT / EXISTING SYSTEM INSPECTION

PROPERTY DESCRIPTION NO. 25080 DATE 9-26-96 TAX MAP NO. 12N-A-86

OWNER OR CONTRACTOR BETTY B. GOODIN PHONE: Business Home 546-7470 Watershed: ☐ Yes ☒ No

ADDRESS P.O. BOX 374 HARMONY, NC 28634

LOCATION US 21 N. TR NC 901 TR CRANFILL ROAD, LOT ON LEFT AT POOL (SEE DRIVE)

SUBDIVISION BLOCK / SECTION LOT LOT AREA 245 X 375 SITE CLASS: PS DESIGN FLOW 360 L.T.A.R. 0.30 GAD/FT²

Septic Tank: 1000 Gallons; STB 564 Date 8-5-90

Pump Tank: 1250 Gallons; PT Date

Pump Make: Model Serial No.

Nitrification Field: No Fields 1 Square Feet 1200 Linear Feet 400

No Lines FOUR Trench Width 36" Max Trench Bottom Depth 36" Gravel Depth 12"

☒ New System ☐ Repair System Type: I, II, III, IV, V, VI

System Description: CONV. GRAVITY

Repair System Description: CONV. GRAVITY

Maintenance Agreement Required: ☐ Yes ☒ No

☐ House/Mod. Home ☒ Mobile Home ☐ Business ☐ Other

No. Bedrooms 3 No. Bathrooms 2 No. Employees


☐ Slab ☒ Crawl Space ☐ Basement w/plumbing ☐ Basement wo/plumbing

Water Supply: ☐ Individual ☐ Community ☒ Public


Comments:

Comments:

INITIAL SITE SKETCH

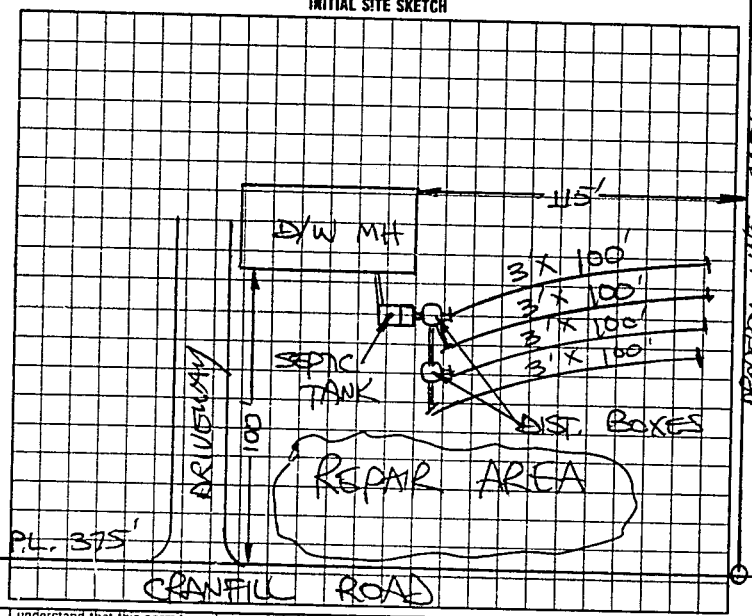

AS BUILT SKETCH

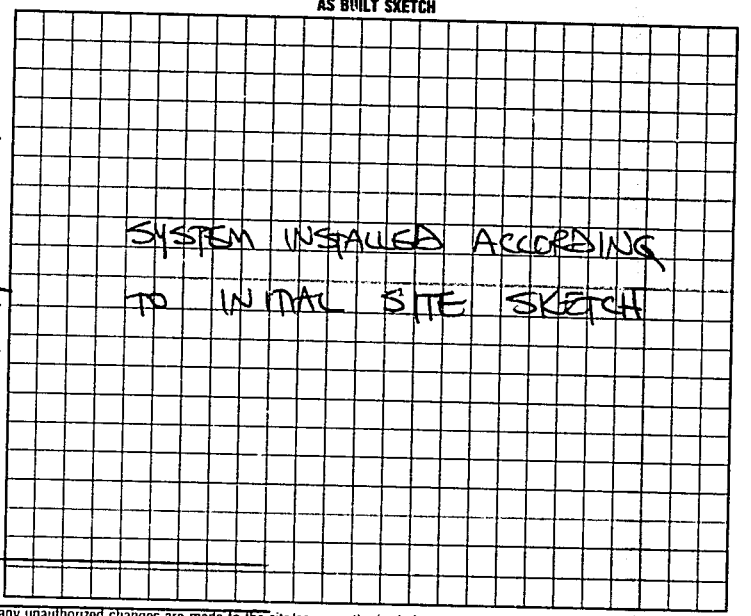

I understand that this permit can be suspended or revoked if any false information is supplied toward securing the permit/any unauthorized changes are made to the site/any unauthorized changes are made in the installation of the system. AUTH. TO CONST. IS VALID FOR A PERIOD EQUAL TO THE VALIDITY OF THE I.P. NOT TO EXCEED FIVE YEARS. I.P. W/SITE PLAN IS VALID 5 YEARS.

Signed: + Betty B. Goodin

Improvement Permit by: STEVE HENDRICK date 9-26-96

Authorization to Construct

Existing System Inspection by STEVE HENDRICK date 9-26-96

Installed by: Tommy FRYE

Certificate of Completion by: date

Operation Permit by STEVE HENDRICK date 3-4-97

HEALTH DEPT COPY: WHITE INSPECTION COPY (FINAL): GREEN OWNER COPY (FINAL): YELLOW INSPECTION COPY (INITIAL): PINK OWNER COPY (INITIAL): GOLD