IREDELL COUNTY HEALTH DEPARTMENT

STATESVILLE 704-878-5305 MOORESVILLE 704-664-5281

IMPROVEMENT PERMIT / CERTIFICATE OF COMPLETION / OPERATION PERMIT / EXISTING SYSTEM INSPECTION

PROPERTY DESCRIPTION NO. REPAIR DATE 12/9/94 TAX MAP NO.

OWNER OR CONTRACTOR ARLIE ABSHER PHONE: Business Watershed: ☐ Yes ☑ No

ADDRESS 220 E. MEMORIAL HWY, HARMONY, NC 28634 Home 546-7820

LOCATION US 21 N, TR NC 901, THIRD HOUSE ON (R) PAST CRAWFILL ROAD

SUBDIVISION BLOCK / SECTION LOT LOT AREA SITE CLASS. PS DESIGN FLOW 360 L.T.A.R. EXISTING

Septic Tank: EXISTING Gallons; STB Date

Pump Tank: Gallons; PT Date

Pump Make: Model Serial No.

Nitrification Field: No Fields 2 Square Feet 450 Linear Feet 150

No Lines 1 Trench Width 36" Max Trench Bottom Depth 36" Gravel Depth 12"

☐ New System ☑ Repair System Type: I, II, III, IV, V, VI

System Description: CONV. GRAVITY

Repair System Description: CONV. GRAVITY

Maintenance Agreement Required: ☐ Yes ☑ No

☑ House/Mod. Home No. Bedrooms 3

☐ Mobile Home No. Bathrooms 1

☐ Business No. Employees

☐ Other


☐ Slab ☑ Crawl Space ☐ Basement w/plumbing ☐ Basement wo/plumbing

Water Supply: ☑ Individual ☐ Community ☐ Public

Comments: ① CHECK SEPTIC TANK FOR INTEGRITY REPLACE SANITARY TEE ② INSTALL NEW DIST. BOX AT LOCATION SHOWN ③ INSTALL NEW 3'x150' NITRIFICATION TRENCH AS SHOWN

Comments: SANITARY TEE REPLACED IN TANK

INITIAL SITE SKETCH

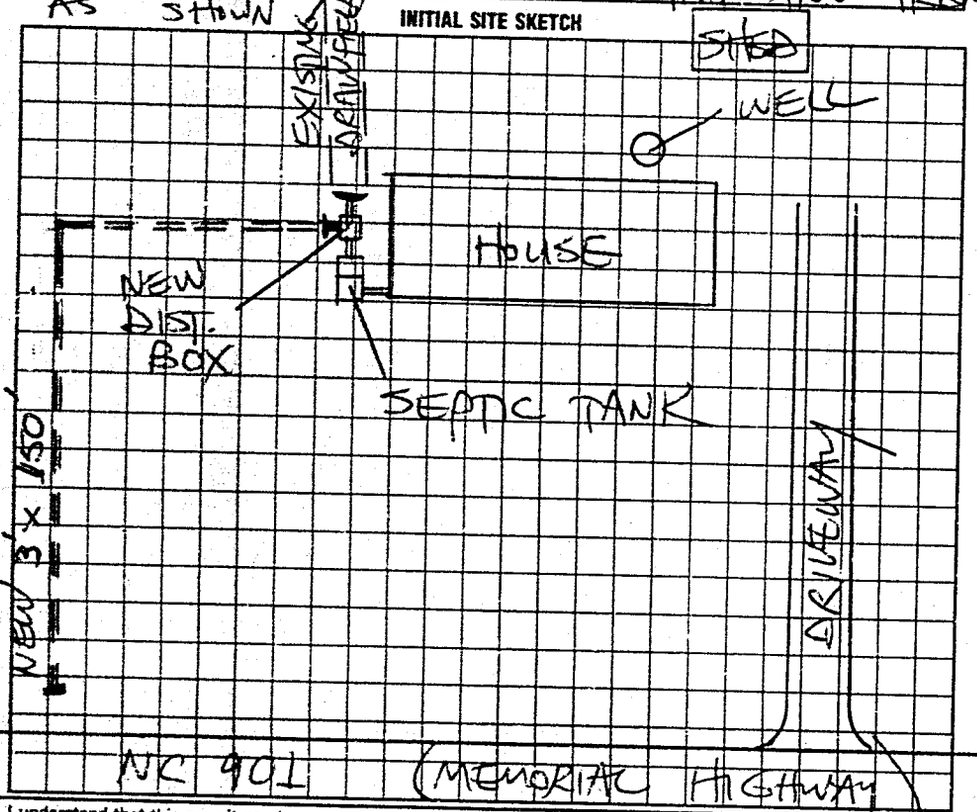

AS BUILT SKETCH

SYSTEM REPAIRED ACCORDING TO INITIAL SITE SKETCH

I understand that this permit can be suspended or revoked if any false information is supplied toward securing the permit/any unauthorized changes are made to the site/any unauthorized changes are made in the installation of the system. Improvement Permit is valid for 60 months from date of issuance.

Signed: X Arlie C Absher

Improvement Permit by: STEVE HEDRICK date 12/9/94

Existing System Inspection by: date

Installed by: SAMMY REAVIS

Certificate of Completion by: STEVE HEDRICK date 12/27/94

Operation Permit by: date

HEALTH DEPT. COPY: WHITE INSPECTION COPY (FINAL): GREEN OWNER COPY (FINAL): YELLOW INSPECTION COPY (INITIAL): PINK OWNER COPY (INITIAL): GOLD