IREDELL COUNTY HEALTH DEPARTMENT

STATESVILLE 704-878-5305 MOORESVILLE 704-664-5281

IMPROVEMENT PERMIT / AUTHORIZATION TO CONSTRUCT / OPERATION PERMIT / EXISTING SYSTEM INSPECTION

PERMIT# 147480 PIN# 4870767367 DATE 1-10-08

OWNER OR APPLICANT Joseph Blankenship PHONE: Business 704 528 9068 Home 704 546 2870

ADDRESS 113 Polly Ann Drive

LOCATION Hwy 21 N, Hwy 901 (R), ½ mile (L) Linda Dr. (L) Polly Ann

SUBDIVISION n/a BLOCK / SECTION _____ LOT 6 LOT AREA _____ SITE CLASS. P5 DESIGN FLOW 360 (ex) L.T.A.R. Ex.

Septic Tank: 1000 Ex Gallons: STB _____ Date _____

Pump Tank: _____ Gallons: PT _____ Date _____

Pump Make: _____ Model _____ Serial No. _____

Nitrification Field: No Fields Ex Square Feet Ex. Linear Feet Ex

No Lines 2 Trench Width Ex. Max Trench Bottom Depth Ex. Gravel Depth Ex. ☐ Gravity ☐ Pressure

☐ New System ☐ Repair ☐ Expansion System Type: I (II) III IV V VI

System Description: _____

Repair System Description: _____

Maintenance Agreement Required: ☐ Yes ☐ No

☐ House/Mod. Home ☒ Mobile Home ☐ Business ☐ Other _____

No. Bedrooms 2 No. Persons _____ No. Employees _____

Water Supply: ☐ Individual ☒ Public ☐ Community


☐ Slab ☒ Crawl Space ☐ Basement w/plumbing ☐ Basement wo/plumbing

Comments:/Conditions:

Comments:/Conditions:

INITIAL SITE SKETCH

AS BUILT SKETCH

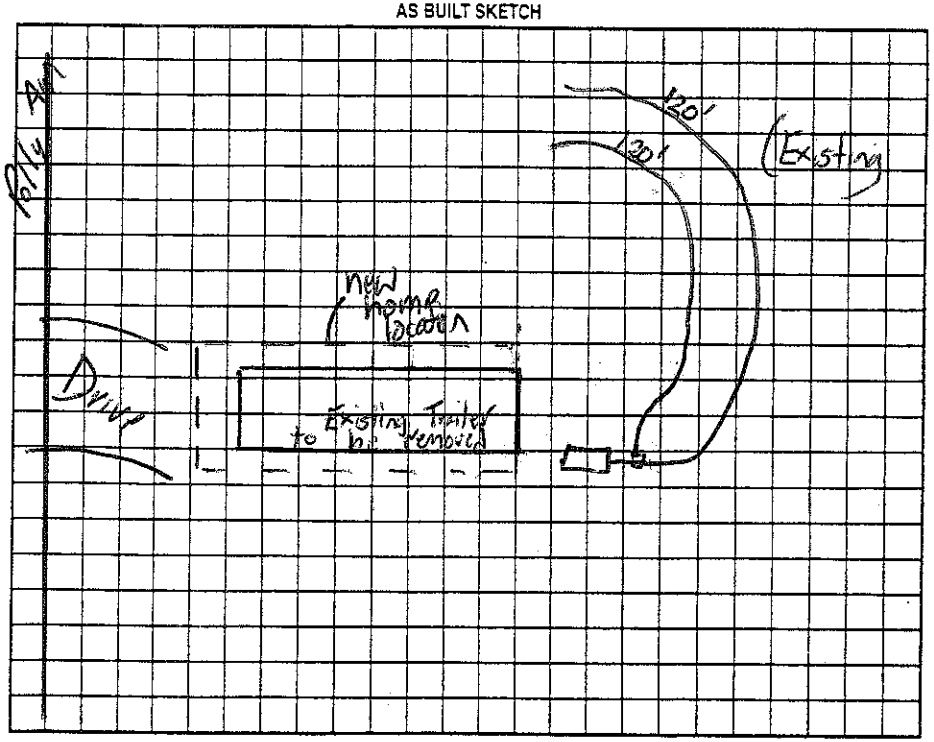

Permit can be suspended or revoked if any false information is supplied toward securing the permit/any unauthorized changes are made to the site/any unauthorized changes are made in the installation of the system. Improvement Permit with plat valid without expiration ☐ Improvement Permit with site plan valid for sixty months ☐ Authorization to Construct is valid for a period equal to that of Improvement Permit – not to exceed sixty months.

Signed: Joseph D Blankenship date 1-10-08

Improvement Permit by: _____ date _____

Authorization to Construct by: _____ date _____

Installed by: _____

Operation Permit by: _____ date _____

Existing System Inspection by: _____ date 1-10-08

HEALTH DEPT. COPY: WHITE OWNER COPY (FINAL): YELLOW OWNER COPY (INITIAL): PINK