IREDELL COUNTY HEALTH DEPARTMENT

STATESVILLE 704-878-5305 MOORESVILLE 704-664-5281

IMPROVEMENT PERMIT / AUTHORIZATION TO CONSTRUCT / OPERATION PERMIT / EXISTING SYSTEM INSPECTION

PERMIT# HARMONY PIN# 4870-77-1227 DATE 3-6-03

OWNER OR CONTRACTOR DERRICK SMITH PHONE: Business 704-978-2717 Home 704-450-8323

ADDRESS 149 ISA'S LUM ST, HARMONY, NC 28634

LOCATION US21 N, TR NC901, TL ISA'S LUM ST, 2ND LOT ON LEFT PAST FIRST CHURCH STREET

SUBDIVISION _____ BLOCK / SECTION _____ LOT _____ LOT AREA 0.700 ACRE SITE CLASS. PS DESIGN FLOW 360 L.T.A.R. 0.30 GPD/FT²

Septic Tank: 1000 Gallons; STB 760 Date 11-2-02
Pump Tank: _____ Gallons; PT _____ Date _____
Pump Make: _____ Model _____ Serial No. _____
Nitrification Field: No Fields 1 Square Feet EQ TO 1200 Linear Feet 300
No Lines THREE Trench Width 36" Max Trench Bottom Depth 36" Gravel Depth N/A

☑ New System ☐ Repair System Type: I, II, (III), IV, V, VI
System Description: 25% REDUCTION, GRAVITY
Repair System Description: 25% REDUCTION, GRAVITY
Maintenance Agreement Required: ☐ Yes ☐ No


☐ House/Mod. Home No. Bedrooms 3
☑ Mobile Home No. Bathrooms 2
☐ Business No. Employees ____
☐ Other _____
☐ Slab ☑ Crawl Space ☐ Basement w/plumbing ☐ Basement wo/plumbing

Water Supply: ☐ Individual ☑ Public ☐ Community


Comments/Conditions: ① INSTALL 25% REDUCTION SYSTEM ON CONTOUR AS FLAGGED ② SEE ATTACHED EASEMENT onto DORIS C. SMITH

Comments/Conditions: ① SEPTIC TANK WITH MARKER INSTALLED USING "LABEL" FILTER ② SYSTEM ALTERED AS SHOWN WITHOUT PRIOR HEALTH DEPARTMENT APPROVAL

INITIAL SITE SKETCH

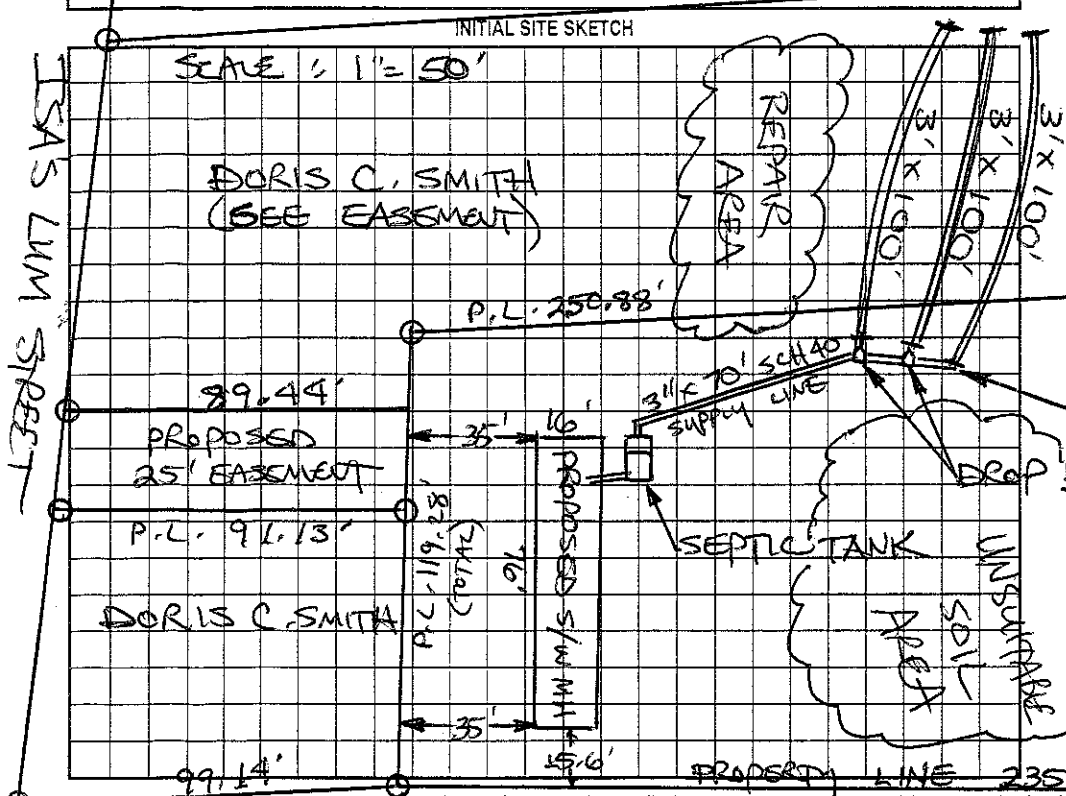

AS BUILT SKETCH

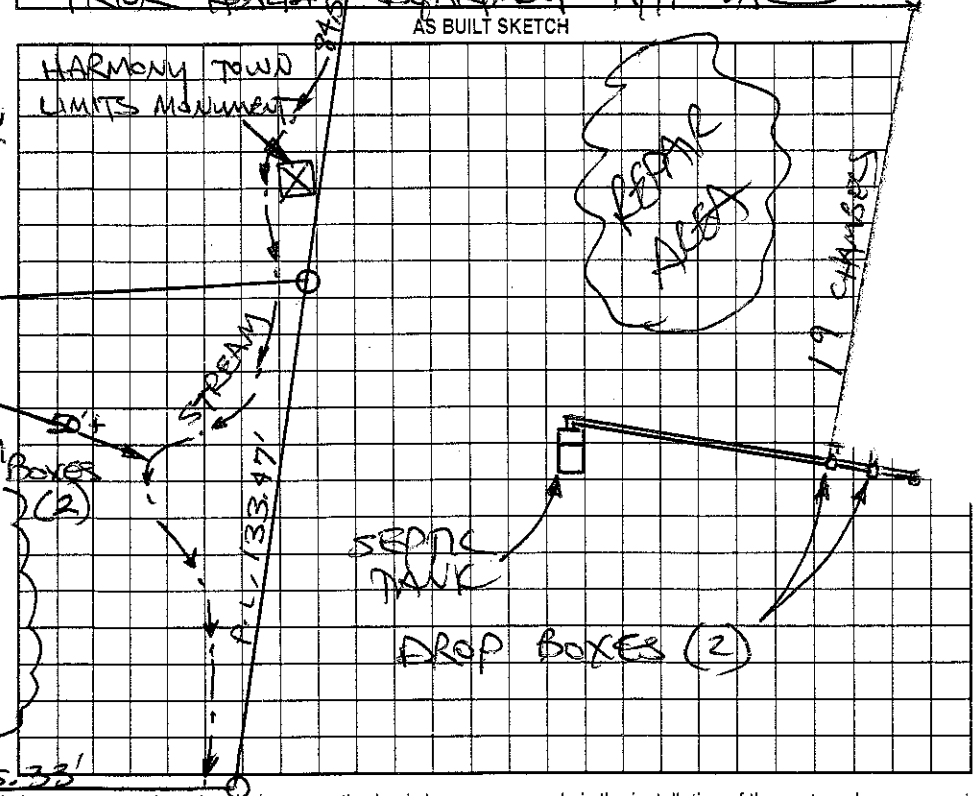

Permit can be suspended or revoked if any false information is supplied toward securing the permit/any unauthorized changes are made to the site/any unauthorized changes are made in the installation of the system. Improvement Permit with plat valid without expiration. Improvement Permit with site plan valid for sixty months. Authorization to Construct is valid for a period equal to that of Improvement Permit – not to exceed sixty months.

Signed: Derrick A. Smith date 3-10-03 Installed by: KEVIN GRUBB, GRADING & HAULING

Improvement Permit by: STEVE HEDRICK date 3-6-03 Operation Permit by: STEVE HEDRICK date 3-26-03

Authorization to Construct by: STEVE HEDRICK date 3-6-03 Existing System Inspection by: _____ date _____

HEALTH DEPT. COPY: WHITE OWNER COPY (FINAL): YELLOW OWNER COPY (INITIAL): PINK