IREDELL COUNTY HEALTH DEPARTMENT

STATESVILLE 704-878-5305 MOORESVILLE 704-664-5281

IMPROVEMENT PERMIT / CERTIFICATE OF COMPLETION / OPERATION PERMIT / EXISTING SYSTEM INSPECTION

PROPERTY DESCRIPTION NO. HARMONY DATE 5-28-97 TAX MAP NO. 561910180 Watershed: ☐ Yes ☑ No

OWNER OR CONTRACTOR LEWIS / HOLBROOK PHONE: Business Home 872-8915

ADDRESS 307 EAST SIDE DRIVE, STATESVILLE, NC 28677

LOCATION US 21 N, TR HIGHLAND AV, TR REDMOND, TR PEPPERTREE TR CEDARVALE, 7TH LOT ON LEFT

SUBDIVISION SAGEFIELD BLOCK / SECTION II LOT 36 LOT AREA 0.752 ACRE SITE CLASS. PS DESIGN FLOW 360 L.T.A.R. 0.30 GPD/FT²

Septic Tank: 1000 Gallons; STB 825 Date 5-2-97

Pump Tank: _____ Gallons; PT _____ Date _____

Pump Make: _____ Model _____ Serial No. _____

Nitrification Field: No Fields 1 Square Feet 1200 Linear Feet 400

No Lines FIVE Trench Width 36" Max Trench Bottom Depth 24"

☑ New System ☐ Repair System Type: I, II, III, IV, V, VI

System Description: CONVENTIONAL GRAVITY

Repair System Description: LOW PRESSURE PIPE

Maintenance Agreement Required: ☐ Yes ☑ No

Gravel Depth 12"

☐ House/Mod. Home ☑ Mobile Home ☐ Business ☐ Other

No. Bedrooms 3 No. Bathrooms 2 No. Employees ____


☐ Slab ☑ Crawl Space ☐ Basement w/plumbing ☐ Basement wo/plumbing

Water Supply: ☐ Individual ☐ Community ☑ Public

Comments: TRENCHES NO DEEPER THAN 24"

Comments:

INITIAL SITE SKETCH

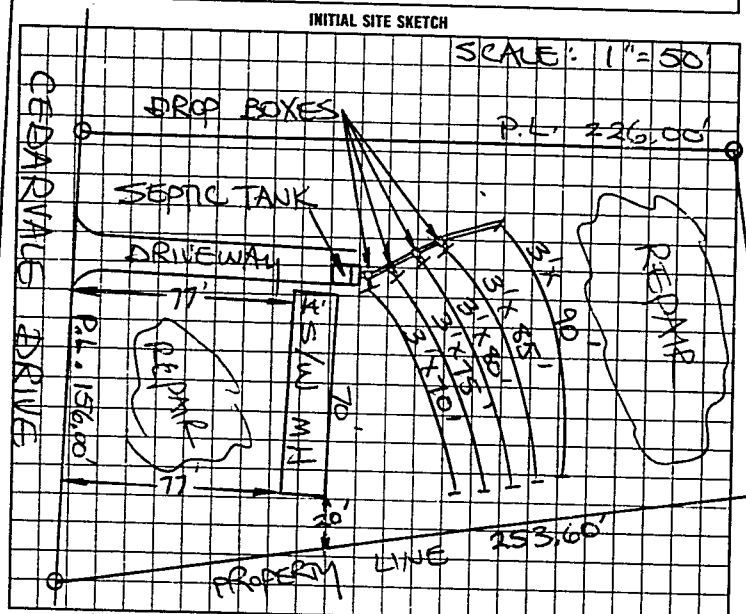

AS BUILT SKETCH

SYSTEM INSTALLED ACCORDING TO INITIAL SITE SKETCH

I understand that this permit can be suspended or revoked if any false information is supplied toward securing the permit/any unauthorized changes are made to the site/any unauthorized changes are made in the installation of the system. Improvement Permit is valid for 60 months from date of issuance. AUTHORIZATION TO CONSTRUCT IS VALID FOR 60 MONTHS FROM DATE OF ISSUE.

Signed: X _____

Improvement Permit by: STEVE HEDRICK date 5-28-97

AUTH. TO CONST

Existing System Inspection by: STEVE HEDRICK date 5-28-97

Installed by: PIEDMONT SEPTIC TANK

~~Certificate of Completion by:~~ _____ date _____

Operation Permit by: STEVE HEDRICK date 6-16-97

HEALTH DEPT COPY: WHITE INSPECTION COPY (FINAL): GREEN OWNER COPY (FINAL): YELLOW INSPECTION COPY (INITIAL): PINK OWNER COPY (INITIAL): GOLD