IREDELL COUNTY HEALTH DEPARTMENT

AUTHORIZATION TO CONSTRUCT

STATESVILLE 704-878-5305 MOORESVILLE 704-664-5281

IMPROVEMENT PERMIT / ~~CERTIFICATE OF COMPLETION~~ / OPERATION PERMIT / EXISTING SYSTEM INSPECTION

PROPERTY DESCRIPTION NO. HARMONY DATE 6/18/97 TAX MAP NO. 4870773719

OWNER OR CONTRACTOR HARMONY PROPERTIES PHONE: Business Home Watershed: ☒ Yes ☐ No

ADDRESS 5551 MONROE RD CHAR NC 28212

LOCATION 21 N - TR TOMLINSON - TR REDMON - TR PEPPERTREE - TR CEDARVALE LOT ON LEFT

SUBDIVISION SAGEFIELD BLOCK / SECTION LOT 37 LOT AREA SITE CLASS. PS DESIGN FLOW 360 GPD L.T.A.R. .36 GPD/FT²

Septic Tank: 1000 Gallons; STB Date 11-12-97

Pump Tank: Gallons; PT Date

Pump Make: Model Serial No.

Nitrification Field: No Fields 1 Square Feet 900 Linear Feet 300

No Lines 3 @ 100' Trench Width 36" Max Trench Bottom Depth 30" Gravel Depth N/A

☒ New System ☐ Repair System Type: I, II, (III) IV, V, VI

System Description: GRAVITY CHAMBERED OR SIMILAR

Repair System Description: ~~SAME~~ Panels

Maintenance Agreement Required: ☐ Yes ☒ No

☐ House/Mod. Home ☒ Mobile Home ☐ Business ☐ Other

No. Bedrooms 3 No. Bathrooms 2 No. Employees


☐ Slab ☒ Crawl Space ☐ Basement w/plumbing ☐ Basement wo/plumbing

Water Supply: ☐ Individual ☐ Community ☒ Public

Comments:

Comments:

INITIAL SITE SKETCH 1" = 50'

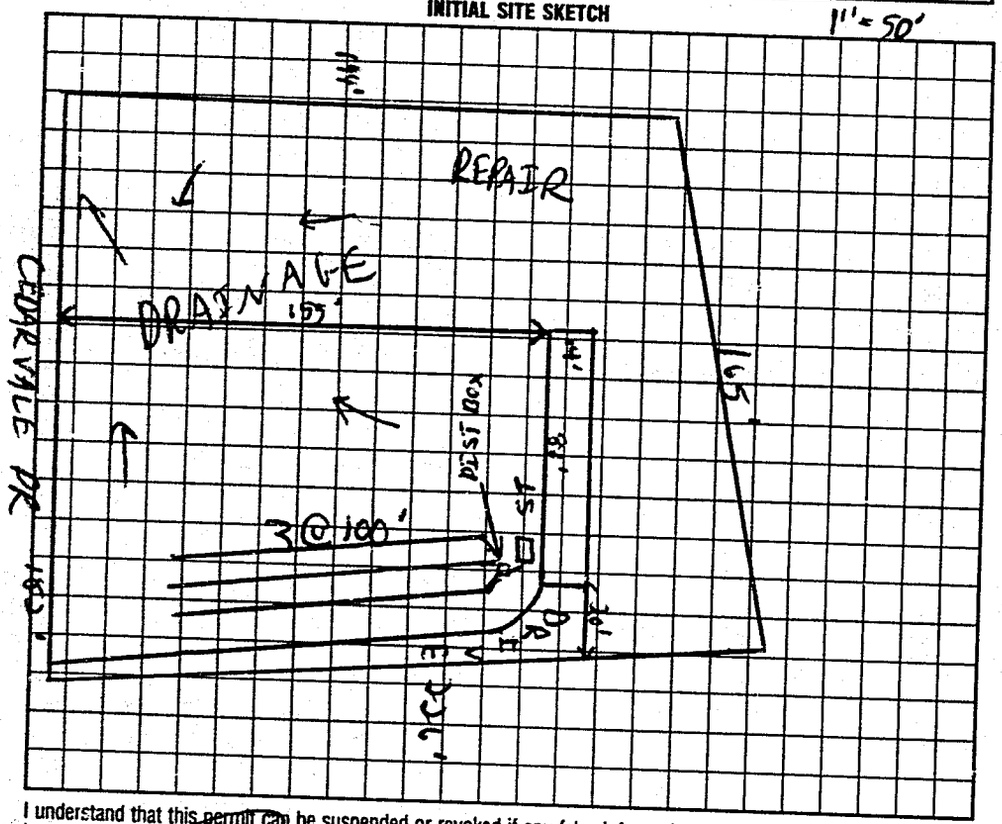

AS BUILT SKETCH

Installed as shown

I understand that this permit can be suspended or revoked if any false information is supplied toward securing the permit/any unauthorized changes are made to the site/any unauthorized changes are made in the installation of the system. Improvement Permit is valid for 60 months from date of issuance.

Signed: James J Barkley

Improvement Permit by: C. Rhyne date 6/18/97

~~Existing System Inspection by:~~ AUTHORIZATION TO CONSTRUCT C. Rhyne date 6/18/97

Installed by: G+M Enterprises

Certificate of Completion by: date

Operation Permit by: Mary Cox RS date 1-12-98

HEALTH DEPT. COPY: WHITE INSPECTION COPY (FINAL): GREEN OWNER COPY (FINAL): YELLOW INSPECTION COPY (INITIAL): PINK OWNER COPY (INITIAL): GOLD