IREDELL COUNTY HEALTH DEPARTMENT

STATESVILLE 704-878-5305 MOORESVILLE 704-664-5281

IMPROVEMENT PERMIT / CERTIFICATE OF COMPLETION / OPERATION PERMIT / EXISTING SYSTEM INSPECTION

PROPERTY DESCRIPTION NO. REPAIR DATE 7/21/93 TAX MAP NO. REPAIR

OWNER OR CONTRACTOR JAMES C CAMPBELL PHONE: Business Home 546-7373

ADDRESS RT. 1 Box 102, HARMONY NC 28634

LOCATION US 21 N, TR NC 901 E, TR CAMPBELL ST, NEXT TO LAST (H) ON (L)

SUBDIVISION BLOCK / SECTION LOT LOT AREA LIMITED SITE CLASS PS L.T.A.R.

Water Supply: ☐ Individual ☐ Community ☑ Public

Septic Tank: EXISTING Gallons; STB Date

Pump Tank: Gallons; PT Date

Nitrification Field: No Fields 1 Square Feet 630 Linear Feet 210

No Lines 3 Trench Width 36" Trench Depth 36" Gravel Depth 12"

☐ New System ☑ Repair System Type: I, II, III, IV, V, VI

System Description: CONV. GRAVITY

Repair System Description:

Maintenance Agreement Required: ☐ Yes ☑ No

☐ House/Mod. Home No. Bedrooms 3 Garbage Disposal: ☐ Yes ☑ No

☐ Mobile Home No. Bathrooms 1 Auto. Dishwasher: ☐ Yes ☐ No


☐ Business No. Employees Auto. Washing Machine: ☐ Yes ☐ No

☐ Other Other


☐ Slab ☑ Crawl Space ☐ Basement w/plumbing ☐ Basement wo/plumbing

Comments (1) CHECK S.T. INTEGRITY, REPLACE SANITARY TEE IF NECESSARY (2) INSTALL NEW D. BOX AT LOCATION SHOWN (3) INSTALL NEW LINES AS SHOWN ON CONTOUR AS SHALLOW AS POSSIBLE (4) FEED EXISTING LINES LAST OUT OF BOX

INITIAL SITE SKETCH

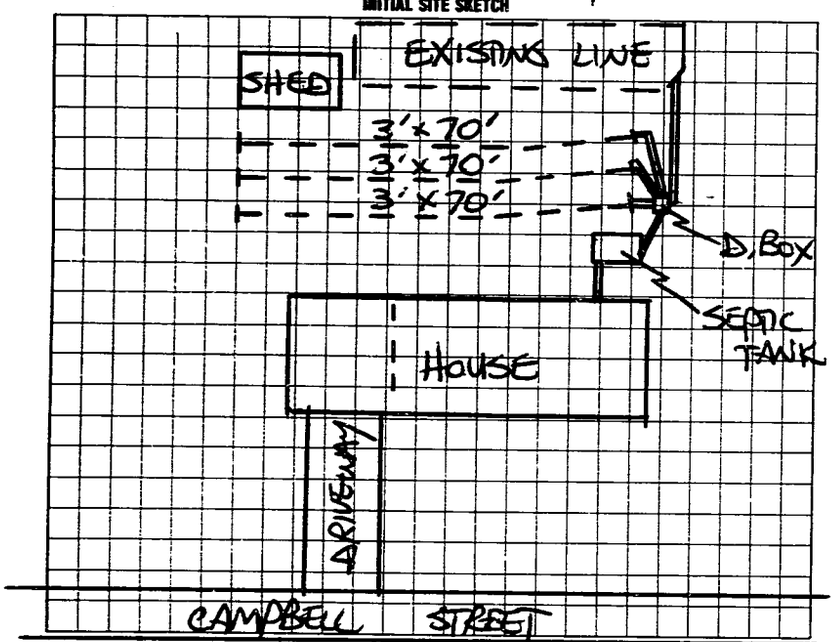

AS BUILT SKETCH

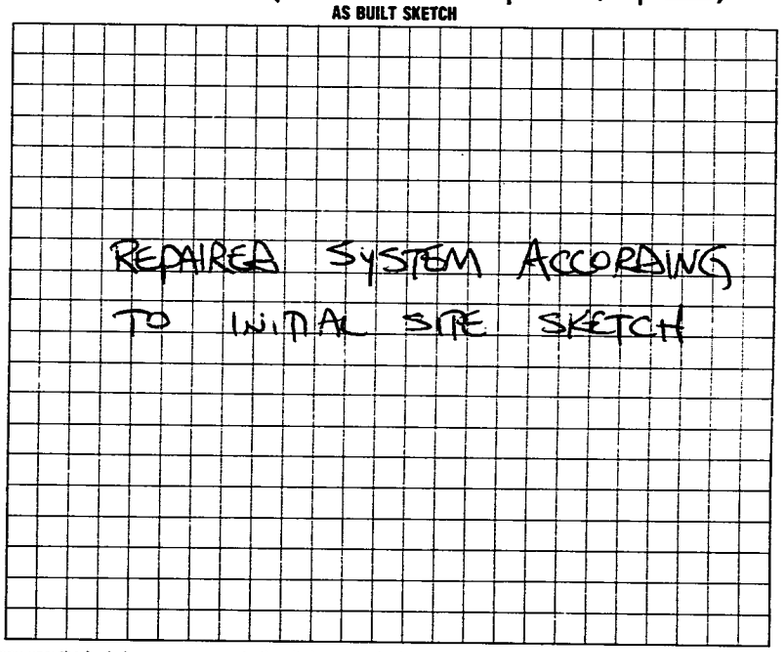

I understand that this permit can be suspended or revoked if any false information is supplied toward securing the permit/any unauthorized changes are made to the site/any unauthorized changes are made in the installation of the system. Improvement Permit is valid for 60 months from date of issuance.

Signed: x James C. Campbell

Improvement Permit by: STEVE HEDRICK date 7/21/93

Existing System Inspection by: date

Installed by: SAMMY REAVIS

Certificate of Completion by: STEVE HEDRICK date 8/4/93

Operation Permit by: date

HEALTH DEPT. COPY: WHITE INSPECTION COPY (FINAL): GREEN OWNER COPY (FINAL): YELLOW INSPECTION COPY (INITIAL): PINK OWNER COPY (INITIAL): GOLD

J