IREDELL COUNTY HEALTH DEPARTMENT

Authorization to Construct

STATESVILLE 704-878-5305 MOORESVILLE 704-664-5281

IMPROVEMENT PERMIT / ~~CERTIFICATE OF COMPLETION~~ / OPERATION PERMIT / EXISTING SYSTEM INSPECTION

PROPERTY DESCRIPTION NO. 067112 DATE 6/13/97 TAX MAP NO. 4870779957 Watershed: X Yes ☐ No

OWNER OR CONTRACTOR Harmony Properties PHONE: Business 532-6527 Home

ADDRESS Cedarvale Dr. Harmony NC. 28634 — 5551 Monroe Rd Charlotte, NC. 28212

LOCATION 21N TR TOMLINSON RD TR RT Redmond Rd. TR Pappentree Rd TR Cedarvale WS III BOW

SUBDIVISION SEDGE FIELD BLOCK / SECTION II LOT 26 LOT AREA .85 AC SITE CLASS. PS DESIGN FLOW 360 L.T.A.R. .35

Septic Tank: 1000 Gallons; STB 1012 Date 4.30.97

Pump Tank: ____ Gallons; PT ____ Date ____

Pump Make: ____ Model ____ Serial No. ____

Nitrification Field: No Fields 1 Square Feet ~~1111~~ Linear Feet ~~342~~ 257

No Lines 3 Trench Width 36" Max Trench Bottom Depth 32" Gravel Depth SAND

X New System ☐ Repair System Type: I, II, (III) IV, V, VI

System Description: GRAV-CH PLASTIC

Repair System Description: PRESSURE-CH PLASTIC

Maintenance Agreement Required: ☐ Yes X No

X House/Mod. Home No. Bedrooms 3

☐ Mobile Home No. Bathrooms 2

☐ Business No. Employees ____

☐ Other ____


☐ Slab X Crawl Space ☐ Basement w/plumbing ☐ Basement wo/plumbing

Water Supply: ☐ Individual X Community ☐ Public


Comments:

Comments:

INITIAL SITE SKETCH 202

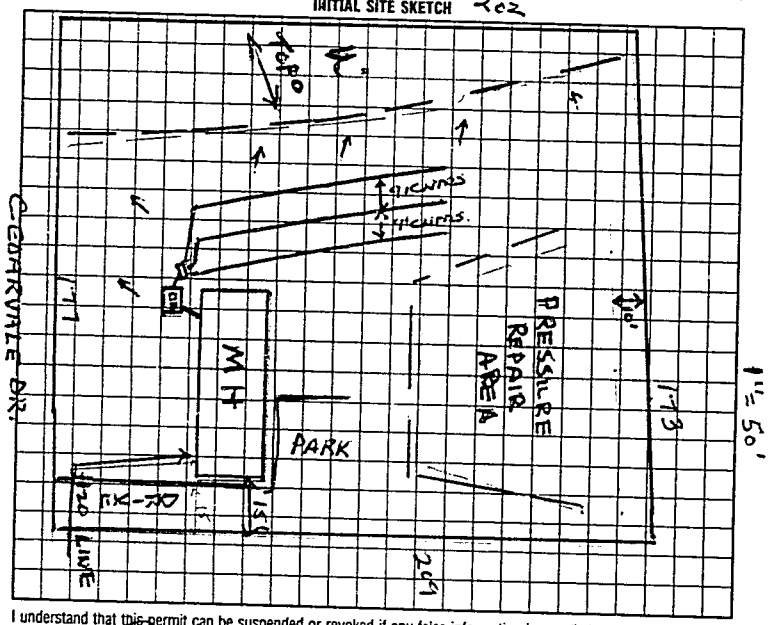

AS BUILT SKETCH

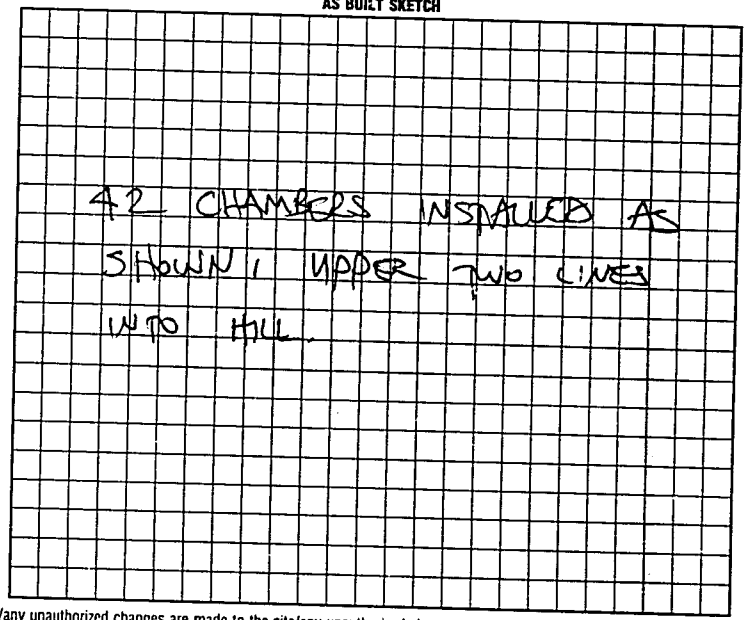

I understand that this permit can be suspended or revoked if any false information is supplied toward securing the permit/any unauthorized changes are made to the site/any unauthorized changes are made in the installation of the system. Improvement Permit is valid for 60 months from date of issuance.

Signed: X

Improvement Permit by: Wesley Sparks RS. date 6/13/97

~~Authorization~~ System Inspection by: Wesley Sparks RS. date 6/13/97

Installed by: A-1 BACKHOE

Certificate of Completion by: ____ date ____

Operation Permit by: STEVE HERRICK date 6-26-97

HEALTH DEPT. COPY: WHITE INSPECTION COPY (FINAL) GREEN OWNER COPY (FINAL) YELLOW INSPECTION COPY (INITIAL) PINK OWNER COPY (INITIAL) GOLD