IREDELL COUNTY HEALTH DEPARTMENT

STATESVILLE 704-878-5305 MOORESVILLE 704-664-5281

IMPROVEMENT PERMIT / AUTHORIZATION TO CONSTRUCT / OPERATION PERMIT / EXISTING SYSTEM INSPECTION

PERMIT# HARMONY PIN# 4870 78 1047 DATE 8-1-98

OWNER OR CONTRACTOR HARMONY PROPERTIES PHONE: Business Home 532-6625

ADDRESS 5551 MONROE ROAD, CHARLOTTE, NC 28212

LOCATION US 21 N, TR HIGHLAND POINT AV, TR REDMON, TR PEPPERTREE, TR CEDARVALE, 8TH LOT ON RIGHT

SUBDIVISION SAGEFIELD BLOCK / SECTION II LOT 30 LOT AREA 1.234 Acres SITE CLASS PS DESIGN FLOW 360 L.T.A.R. 0.30 GPD/FT²

Septic Tank: 1000 Gallons; STB 7-96 Date 12-22-98
Pump Tank: ____ Gallons; PT ____ Date ____
Pump Make: ____ Model ____ Serial No. ____
Nitrification Field: No Fields 1 Square Feet Eq. To 1200 Linear Feet 300+
No Lines FOUR Trench Width 36" Max Trench Bottom Depth 30"

[X] New System [ ] Repair System Type: I, II, (III), IV, V, VI
System Description: 25% REDUCTION GRAVITY
Repair System Description: ~~25% REDUCTION~~ GRAVITY
Maintenance Agreement Required: [ ] Yes [X] No
Bed Depth SAND 6" [ ] Slab [X] Crawl Space [ ] Basement w/plumbing [ ] Basement wo/plumbing


[ ] House/Mod. Home No. Bedrooms 3
[X] Mobile Home No. Bathrooms 2
[ ] Business No. Employees ____
[ ] Other ____

Water Supply: [ ] Individual [X] Public [ ] Community


Comments:/Conditions: INSTALL 25% REDUCTION SYSTEM USING FIFTY CHAMBERS OR THIRTY H.D.S. SECTIONS USING DROP BOXES FOR SERIAL DISTRIBUTION.

Comments:/Conditions:

INITIAL SITE SKETCH

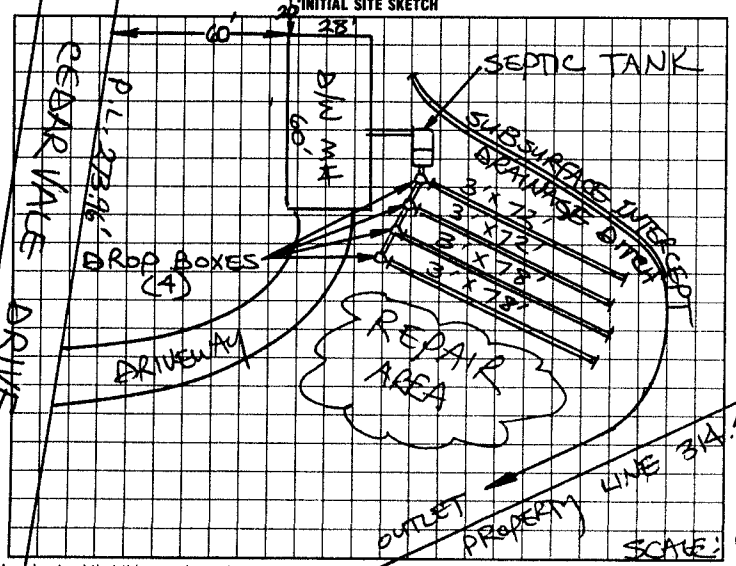

AS BUILT SKETCH

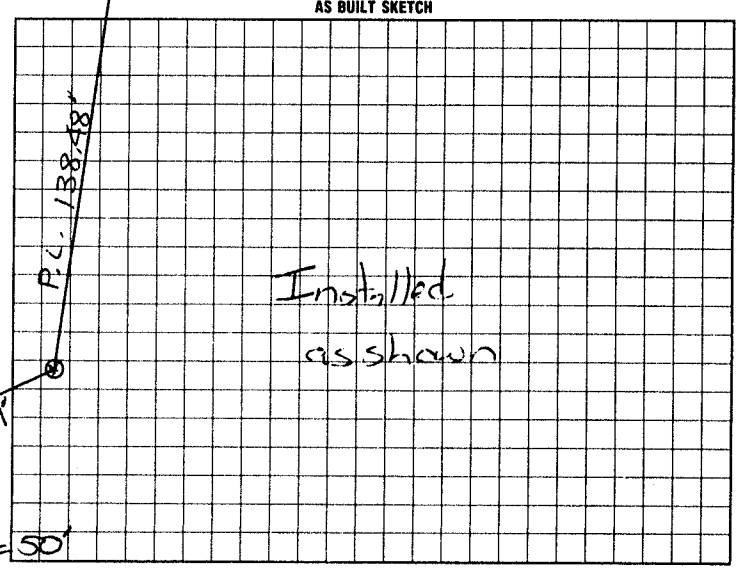

I understand that this permit can be suspended or revoked if any false information is supplied toward securing the permit/any unauthorized changes are made to the site/any unauthorized changes are made in the installation of the system. Improvement Permit with plat valid without expiration. Improvement Permit with site plan valid for sixty months. Authorization to Construct is valid for a period equal to that of Improvement Permit – not to exceed sixty months.

Signed: _____ date 8-6-98 Installed by: C & M Enterprises

Improvement Permit by: STEVE HEDRICK date 8-1-98 Operation Permit by: Mark C Cutts RS date 3-11-99

Authorization to Construct by: STEVE HEDRICK date 8-1-98 Existing System Inspection by: _____ date _____

HEALTH DEPT. COPY: WHITE INSPECTION COPY (FINAL): GREEN OWNER COPY (FINAL): YELLOW INSPECTION COPY (INITIAL): PINK OWNER COPY (INITIAL): GOLD