61452

IREDELL COUNTY HEALTH DEPARTMENT

STATESVILLE 704-878-5305 MOORESVILLE 704-664-5281

IMPROVEMENT PERMIT / CERTIFICATE OF COMPLETION / OPERATION PERMIT / EXISTING SYSTEM INSPECTION

PROPERTY DESCRIPTION NO. HARMONY DATE 8-29-96 TAX MAP NO. 12N-A-200 Watershed: ☐ Yes ☑ No

OWNER OR CONTRACTOR DWIGHT T. & TAMMY GOODIN PHONE: Business Home 546-2297

ADDRESS 125 HIGHLAND POINT AVENUE, HARMONY, NC 28634

LOCATION US 21 N, TR HIGHLAND POINT AVENUE, 6N RIGHT JUST PAST SHARP CURVE TO LEFT

SUBDIVISION BLOCK / SECTION LOT LOT AREA AMPLE SITE CLASS. PS DESIGN FLOW 485 L.T.A.R. 0.30 GPD/FT²

Septic Tank: 1600 Gallons; STB 790 Date 4-14-93
Pump Tank: Gallons; PT Date
Pump Make: Model Serial No
Nitrification Field: No Fields 1 Square Feet 1620 Linear Feet 540
No Lines SIX Trench Width 36" Max Trench Bottom Depth 24" Gravel Depth 12"

☑ New System ☐ Repair System Type: I, II, III, IV, V, VI
System Description: CONVENTIONAL GRAVITY
Repair System Description: CHAMBERED, PUMP
Maintenance Agreement Required: ☐ Yes ☑ No
☐ Slab ☑ Crawl Space ☐ Basement w/plumbing ☐ Basement wo/plumbing


☐ House/Mod. Home No. Bedrooms 3
☑ Mobile Home No. Bathrooms 2
☐ Business No. Employees 1
☐ Other BEAUTY SHOP W/1 CHAIR

Water Supply:
☐ Individual
☐ Community
☑ Public


Comments: ① USE ONE FLOW DIVIDER TEE TO ACHIEVE EQUAL DISTRIBUTION INTO TWO SERIES OF DISTRIBUTION BOXES. ② INSTALL LINES IN LENGTHS AS SHOWN BELOW, ON CONTOUR, 9' MINIMUM APART ON CENTERS (AS FLAGGED)

Comments:

INITIAL SITE SKETCH

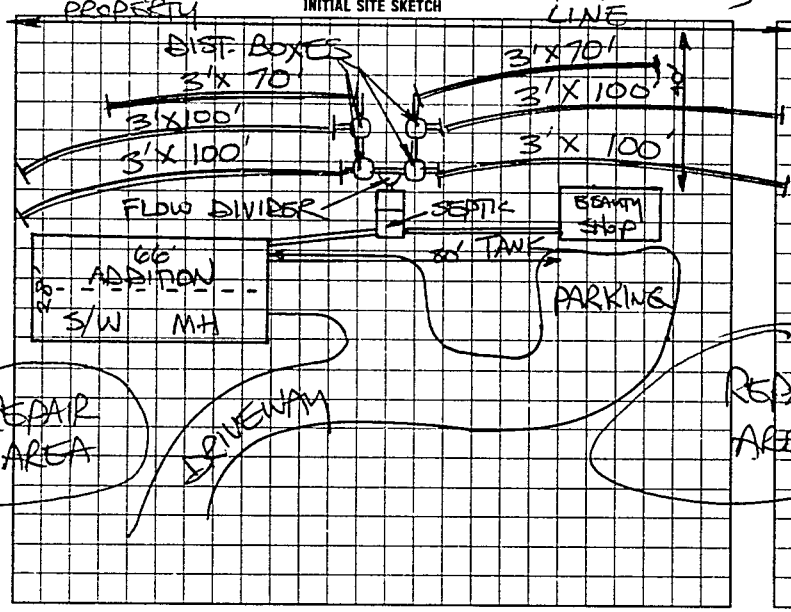

AS BUILT SKETCH

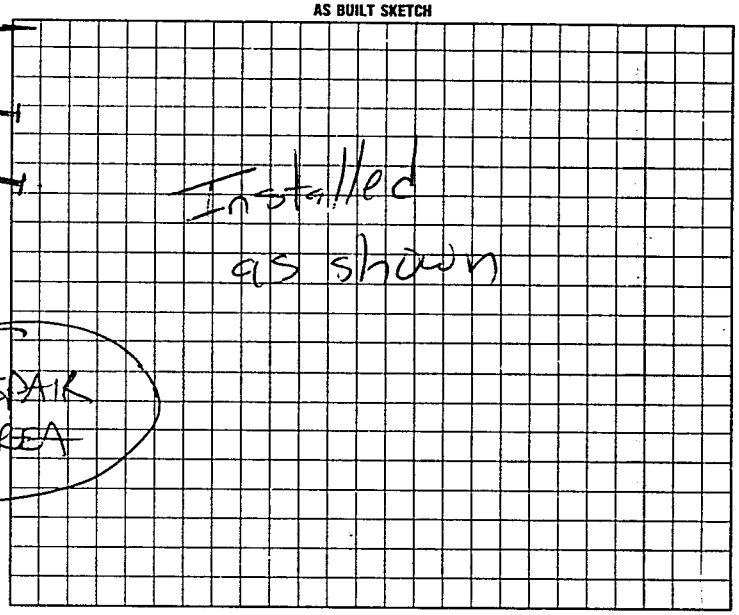

I understand that this permit can be suspended or revoked if any false information is supplied toward securing the permit/any unauthorized changes are made to the site/any unauthorized changes are made in the installation of the system.

AUTH. TO CONST. IS VALID FOR THE PERIOD EQUAL TO THE VALIDITY OF THE I.P. NOT TO EXCEED FIVE YEARS. I.P. W/SITE PLAN IS VALID FIVE YEARS.

Signed: D. Todd Goodin Installed by: Tommy Fox

Improvement Permit by: STEVE HEDRICK date 8-29-96 Certificate of Completion by: date

AUTHORIZATION TO Construct / Existing System Inspection by: STEVE HEDRICK date 8-29-96 Operation Permit by: RS date 10-7-96

HEALTH DEPT COPY: WHITE INSPECTION COPY (FINAL): GREEN OWNER COPY (FINAL): YELLOW INSPECTION COPY (INITIAL): PINK OWNER COPY (INITIAL): GOLD