82215

IREDELL COUNTY HEALTH DEPARTMENT

STATESVILLE 704-878-5305 MOORESVILLE 704-664-5281

IMPROVEMENT PERMIT / AUTHORIZATION TO CONSTRUCT / OPERATION PERMIT / EXISTING SYSTEM INSPECTION

PERMIT# HARMONY PIN# DATE 6-1-99

OWNER OR CONTRACTOR BILLY JOE HARRIS PHONE: Business Home 546-7874

ADDRESS 221 PINEY GROVE ROAD, HARMONY, NC 28634

LOCATION US 21 NORTH, L TR HIGHLAND POINT AVENUE, LOT ON RIGHT AT BOX # 176

SUBDIVISION BLOCK / SECTION LOT LOT AREA LIMITED SITE CLASS PS DESIGN FLOW 360 L.T.A.R. 0.4 GPD/FT²

Septic Tank: EXISTING Gallons; STB Date

Pump Tank: Gallons; PT Date

Pump Make: Model Serial No.

Nitrification Field: No Fields 1 Square Feet EQ TO 900 Linear Feet 225+

No Lines FOUR Trench Width 36" Max Trench Bottom Depth 36" Gravel Depth SAND 6"

☐ New System ☑ Repair System Type: I. II. III. IV. V. VI

System Description: 25% REDUCTION GRAY

Repair System Description: MAX REDUCTION

Maintenance Agreement Required: ☐ Yes ☑ No

☐ House/Mod. Home ☑ Mobile Home ☐ Business ☐ Other

No. Bedrooms 3 No. Bathrooms 2 No. Employees


☐ Slab ☐ Crawl Space ☐ Basement w/plumbing ☐ Basement wo/plumbing

Water Supply: ☐ Individual ☐ Public ☐ Community WELL NEAR POOL


Comments/Conditions: THIS PERMIT SERVES AS NOTICE OF VIOLATION, SYSTEM MUST BE REPAIRED BY JULY 1, 1999 (30 DAYS) @ INSTALL 25% REDUCTION SYSTEM USING 38 CHAMBERS OR 33 HDS SECTIONS

Comments/Conditions: DO NOT ISSUE BUILDING PERMIT UNTIL SYSTEM REPAIRED

INITIAL SITE SKETCH

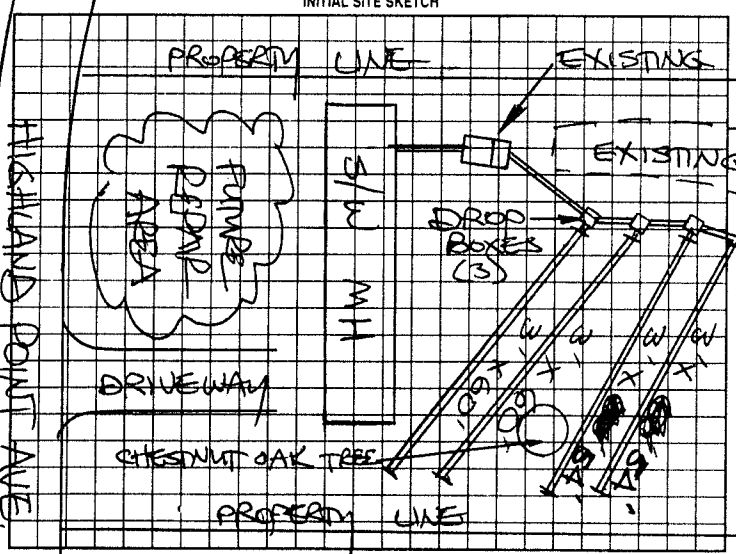

AS BUILT SKETCH

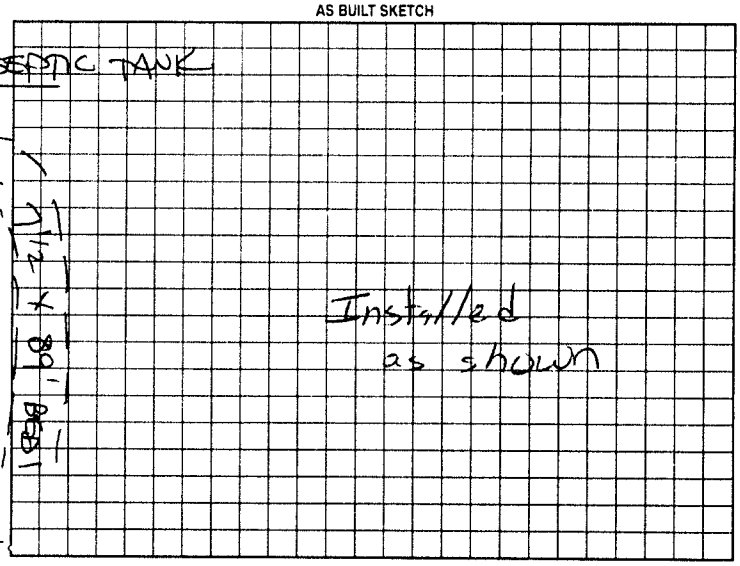

Permit can be suspended or revoked if any false information is supplied toward securing the permit/any unauthorized changes are made to the site/any unauthorized changes are made in the installation of the system. Improvement Permit with plat valid without expiration. Improvement Permit with site plan valid for sixty months. Authorization to Construct is valid for a period equal to that of Improvement Permit -- not to exceed sixty months.

Signed: Billy J. Harris date 6-1-99

Improvement Permit by: STEVE HEDRICK date 6-1-99

Authorization to Construct by: STEVE HEDRICK date 6-1-99

Installed by: Tuckers Hauling & Grading

Operation Permit by: Mark Cody RS date 6-23-99

Existing System Inspection by: date

HEALTH DEPT COPY WHITE OWNER COPY (FINAL) YELLOW OWNER COPY (INITIAL) PINK