pd 925 12-5-97

IREDELL COUNTY HEALTH DEPARTMENT

STATESVILLE 704-878-5305 MOORESVILLE 704-664-5281

IMPROVEMENT PERMIT / CERTIFICATE OF COMPLETION / OPERATION PERMIT / EXISTING SYSTEM INSPECTION

PROPERTY DESCRIPTION NO. 070381 DATE 12-1-97 TAX MAP NO. 4870 78 6449 Watershed: ☐ Yes ☑ No

OWNER OR CONTRACTOR HARMONY PROPERTIES, INC. PHONE: Business Home 532-6527

ADDRESS 5551 MONROE ROAD, CHARLOTTE, NC 28212

LOCATION US 21 N, TR TOMLINSON AVE, TR REDMON RD, TR PEPPERTREE, TR NETTLEBROOK, LOT ON RIGHT AT END

SUBDIVISION SAGEFIELD BLOCK / SECTION II LOT 15 LOT AREA 1.401 ACRES SITE CLASS. PS DESIGN FLOW 360 L.T.A.R. 0.30 GPD/FT²

Septic Tank: 1000 Gallons; STB 821 Date 8-7-98
Pump Tank: Gallons; PT Date
Pump Make: Model Serial No.
Nitrification Field: No Fields 1 Square Feet EST. TO 1200 Linear Feet 300'
No Lines FIVE Trench Width 36" Max Trench Bottom Depth 30"

☑ New System ☐ Repair System Type: I, II, ☑ III, IV, V, VI
System Description: CHAMBERED GRAVITY
Repair System Description: CHAMBERED GRAVITY
Maintenance Agreement Required: ☐ Yes ☑ No (CLASS)
~~Gravel~~ Depth SAND 6"


☐ House/Mod. Home No. Bedrooms 3
☐ Mobile Home No. Bathrooms 2
☐ Business No. Employees
☐ Other
☐ Slab ☑ Crawl Space ☐ Basement w/plumbing ☐ Basement wo/plumbing

Water Supply: ☐ Individual ☐ Community ☑ Public


Comments: INSTALL FIFTY CHAMBERS IN FIVE EQUAL LENGTH LINES AS SHOWN USING SERIAL DISTRIBUTION — LINES NO DEEPER THAN 30"

Comments:

INITIAL SITE SKETCH SCALE: 1" = 60'

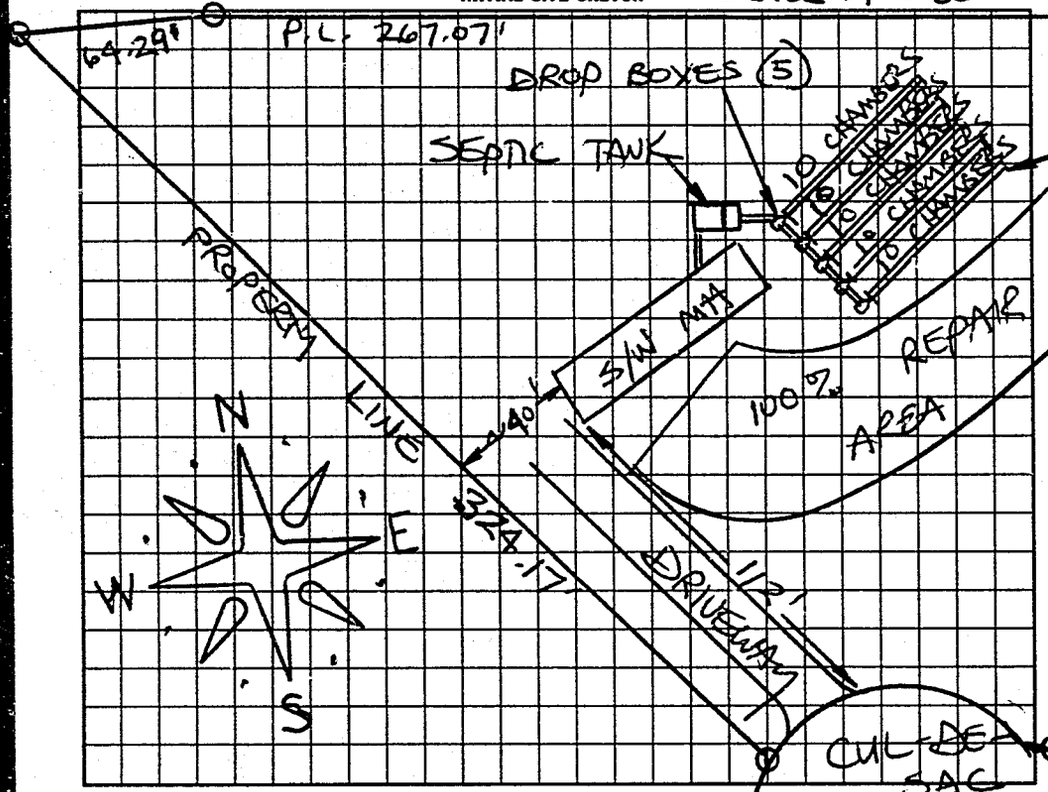

AS BUILT SKETCH

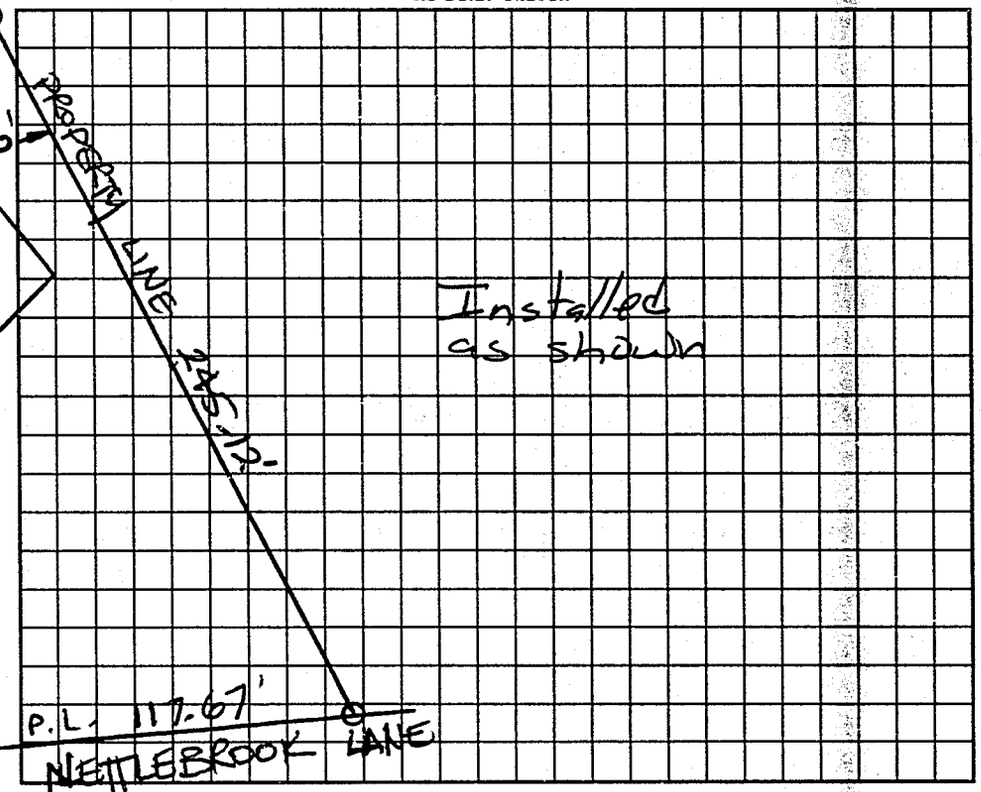

I understand that this permit can be suspended or revoked if any false information is supplied toward securing the permit/any unauthorized changes are made to the site/any unauthorized changes are made in the installation of the system. Improvement Permit is valid for 60 months from date of issuance. AUTHORIZATION TO CONSTRUCT IS VALID FOR 60 MONTHS FROM DATE OF ISSUANCE.

Signed:

Improvement Permit by: STEVE HEDRICK date 12-1-97

AUTH. TO CONST. ~~Existing System Inspection~~ by: STEVE HEDRICK date 12-1-97

Installed by: G & M Enterprise

~~Certificate of Completion by:~~ date

Operation Permit by: Mat C O.J RS date 9-15-98

HEALTH DEPT. COPY: WHITE INSPECTION COPY (FINAL): GREEN OWNER COPY (FINAL): YELLOW INSPECTION COPY (INITIAL): PINK OWNER COPY (INITIAL): GOLD

1.14100