IREDELL COUNTY HEALTH DEPARTMENT

STATESVILLE 704-878-5305 (ad) (ai) MOORESVILLE 704-664-5281

IMPROVEMENT PERMIT / AUTHORIZATION TO CONSTRUCT / OPERATION PERMIT / EXISTING SYSTEM INSPECTION

PERMIT # 15305 PIN # 4876877749 DATE 10-21-08

OWNER or APPLICANT Freedom Camp #6064 PHONE: Business Home:

OWNER or APPLICANT ADDRESS 1270 Northside Drive Statesville NC 28677

LOCATION / DIRECTIONS 2W @ Highland @ Redmon - House on right

SUBDIVISION Sagefield BLOCK / SECTION 1 LOT # 6 LOT AREA 9.19 DESIGN FLOW 360 L.T.A.R. .25

Septic Tank 1050 Gallons: STB 1012 Date 3-29-08

Pump Tank Gallons: P T Date

Pump Make Model Serial #

Nitrification Field No Fields No Lines 4 Linear Feet 360

Trench Width 36" Max. Trench Bottom Depth 30" Gravel Depth NA

☑ New System ☐ Repair ☐ Expansion System Type I II III IV V VI

System Description: 2570 6 count

Repair System Description: pump 2570

Maintenance Agreement Required ☐ YES ☐ NO

☑ GRAVITY ☐ PRESSURE

☑ Residence No. Bedrooms 3

☐ Business No. Persons

☐ Other No. Employees

☐ Slab ☑ Crawl Space

☐ Basement w/plumbing ☐ Basement w/o plumbing

Water Supply: ☐ Private ☑ Public ☐ Community


Comments / Conditions

Existed. on Cottage
Maintain all setbacks


Comments / Conditions

30" Trench bottom

INITIAL SITE SKETCH

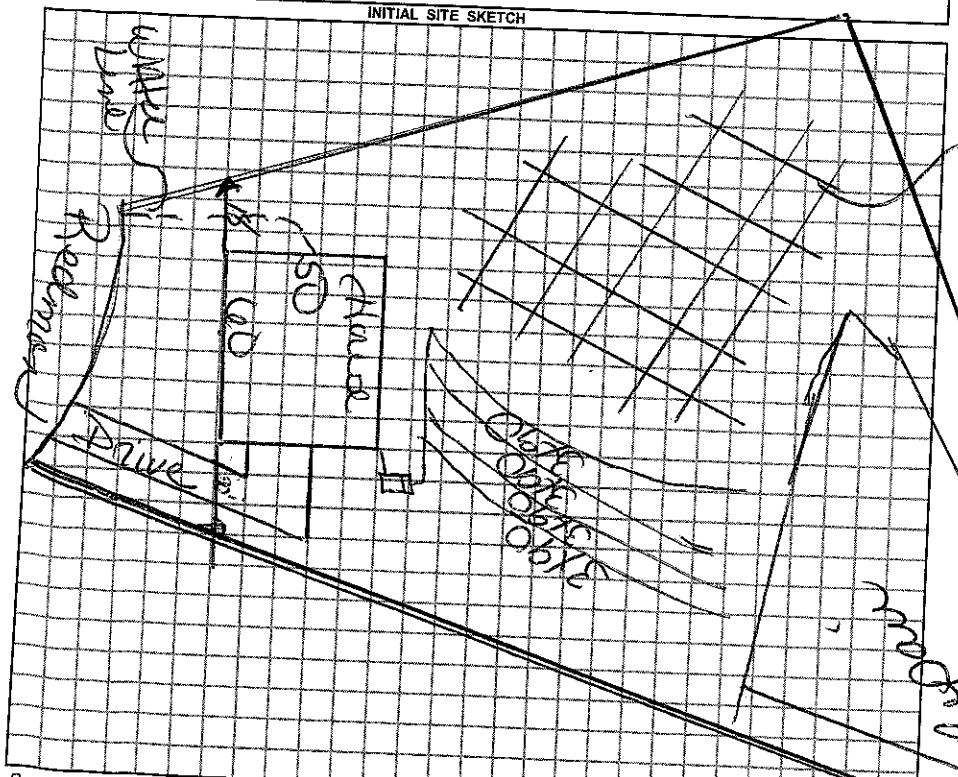

AS BUILT SKETCH

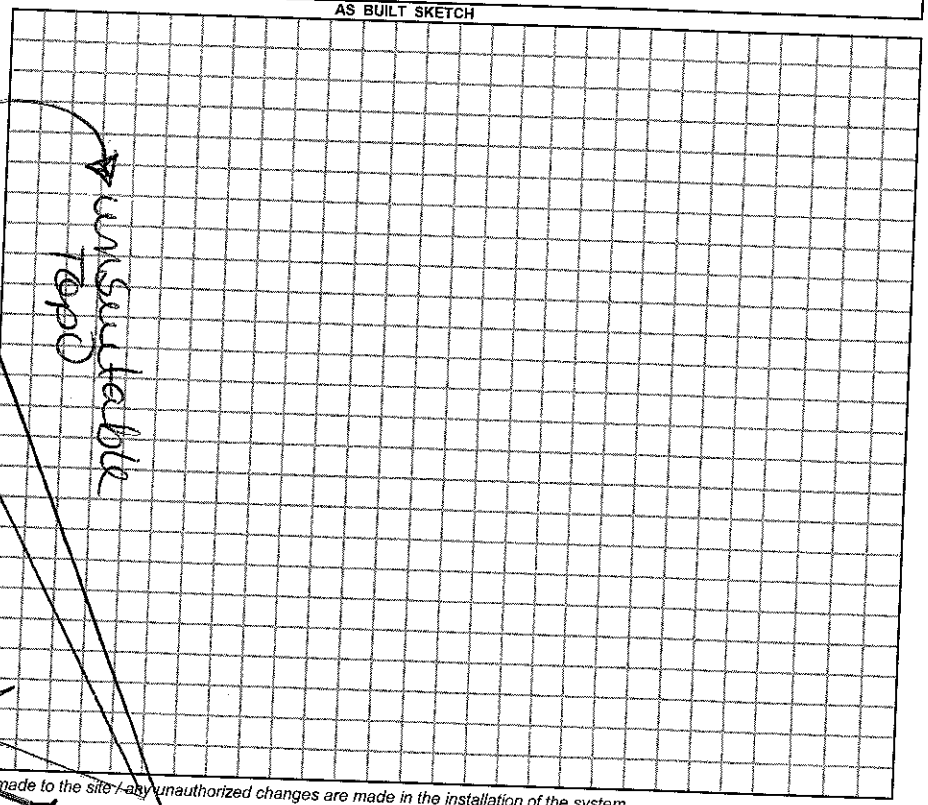

Permit can be suspended or revoked if any false information is supplied toward securing the permit / any unauthorized changes are made to the site / any unauthorized changes are made in the installation of the system.

☐ *IMPROVEMENT PERMIT w / plat valid without expiration.* ☐ *IMPROVEMENT PERMIT w / site plan valid for 60 mos.* ☑ *AUTHORIZATION TO CONSTRUCT valid for period equal to IMPROVEMENT PERMIT-not to exceed 60 mo.*

Owner / Applicant Signature: Date 10-21-08

Improvement Permit by: Date 10-21-08

Authorization to Construct by: Date 10-21-8

YOU SHOULD CONTACT A LOCATOR SERVICE PRIOR TO ANY EXCAVATION.

Installed by: C&S Grading

Operation Permit by: Date: 10-30-08

Existing System Inspected by: Date:

WHITE COPY Environmental Health YELLOW COPY (Final) Owner / Applicant PINK COPY (Initial) Owner / Applicant