12N-A-7 on Computer

IREDELL COUNTY HEALTH DEPARTMENT

STATESVILLE 704-878-5305 MOORESVILLE 704-664-5281

IMPROVEMENT PERMIT / CERTIFICATE OF COMPLETION / OPERATION PERMIT / EXISTING SYSTEM INSPECTION

PROPERTY DESCRIPTION NO. 21958 DATE 8-30-95 TAX MAP NO. 12N-A-102 Watershed: ☐ Yes ☑ No

OWNER OR CONTRACTOR CAROLYN GARY PHONE: Business Home 872-9856

ADDRESS 1210 ROWING LANE STATESVILLE, NC 28677

LOCATION US 21 N, TR TOMLINSON ROAD, TR REDMOND ROAD, LOT ON (R) PAST CURVE,

SUBDIVISION SAGEFIELD BLOCK / SECTION I LOT 7 LOT AREA 34,083 FT² SITE CLASS PS DESIGN FLOW 360 L.T.A.R. 0.3 GAD/FT2

Septic Tank: 1000 Gallons; STB 821 Date 9-13-95

Pump Tank: Gallons; PT Date

Pump Make: Model: Serial No.

Nitrification Field: No Fields 1 Square Feet 1200 Linear Feet 400

No Lines 3 Trench Width 36" Max Trench Bottom Depth 18-28" Gravel Depth 12"

☑ New System ☐ Repair System Type: I (II) III, IV, V, VI

System Description: CONVENTIONAL GRAVITY

Repair System Description: CONV. GRAVITY

Maintenance Agreement Required: ☐ Yes ☑ No

☐ House/Mod. Home No. Bedrooms 3

☑ Mobile Home No. Bathrooms 2

☐ Business No. Employees

☐ Other


☐ Slab ☑ Crawl Space ☐ Basement w/plumbing ☐ Basement wo/plumbing

Water Supply: ☑ Individual ☐ Community ☐ Public WELL

Comments: (1) KEEP WELL 100' FROM SYSTEM (2) INSTALL LINES ON CONTOUR NO DEEPER THAN 28" 9' MINIMUM APART ON CENTERS.

Comments:

INITIAL SITE SKETCH

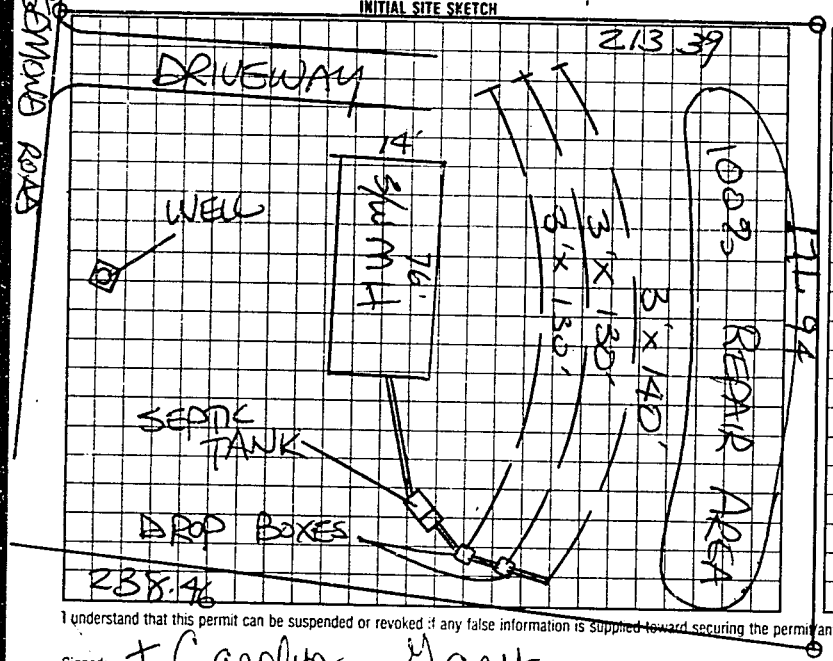

AS BUILT SKETCH

SYSTEM INSTALLED ACCORDING TO INITIAL SITE SKETCH

I understand that this permit can be suspended or revoked if any false information is supplied toward securing the permit any unauthorized changes are made to the site/any unauthorized changes are made in the installation of the system.

Signed: + Carolyn Gary

Improvement Permit by: STEVE HEDRICK date 8-30-95

Existing System Inspection by: date

Installed by: G & M ENTERPRISES

Certificate of Completion by: date

Operation Permit by STEVE HEDRICK date 10-13-95

HEALTH DEPT COPY: WHITE INSPECTION COPY (FINAL): GREEN OWNER COPY (FINAL): YELLOW INSPECTION COPY (INITIAL): PINK OWNER COPY (INITIAL): GOLD

000328