IREDELL COUNTY HEALTH DEPARTMENT

STATESVILLE 704-878-5305 MOORESVILLE 704-664-5281

IMPROVEMENT PERMIT / CERTIFICATE OF COMPLETION / OPERATION PERMIT / EXISTING SYSTEM INSPECTION

PROPERTY DESCRIPTION NO. 22240 DATE 9-25-95 TAX MAP NO. 12N-A-102 (PART OF) Watershed: ☐ Yes ☑ No

OWNER OR CONTRACTOR KENT GREEN PHONE: Business _____ Home 546-7583

ADDRESS 148 HAYES STREET HARMONY NC 28634

LOCATION US 21 N, TR HIGHLAND POINT AVENUE, 3RD LOT ON RIGHT PAST COMMUNITY CENTER

SUBDIVISION SAGEFIELD BLOCK / SECTION I LOT 3 LOT AREA 145.61' x 225.86' SITE CLASS. PS DESIGN FLOW 360 L.T.A.R. 0.25 gpd/ft²

Septic Tank: 1000 Gallons; STB 7-AE-95 Date 7-11-95

Pump Tank: _____ Gallons; PT 620 Date _____

Pump Make: _____ Model _____ Serial No. _____

Nitrification Field: No Fields 1 Square Feet 1440 Linear Feet 480

No Lines 5 Trench Width 36" Max Trench Bottom Depth 24" Gravel Depth 12"

☑ New System ☐ Repair System Type: I, II, III, IV, V, VI

System Description: CONVENTIONAL GRAVITY

Repair System Description: CONV. PUMP-FED

Maintenance Agreement Required: ☐ Yes ☐ No

☐ House/Mod. Home ☑ Mobile Home ☐ Business ☐ Other

No. Bedrooms 3 No. Bathrooms 2 No. Employees _____


☐ Slab ☑ Crawl Space ☐ Basement w/plumbing ☐ Basement wo/plumbing

Water Supply: ☐ Individual ☐ Community ☑ Public


Comments: ① KEEP SYSTEM MINIMUM 10' FROM PROPERTY LINE, 5' FROM MH, 10' FROM WATER LINE ② INSTALL LINES ON CONTOUR, NO DEEPER THAN 24", 9' MINIMUM APART ON CENTER

Comments:

INITIAL SITE SKETCH

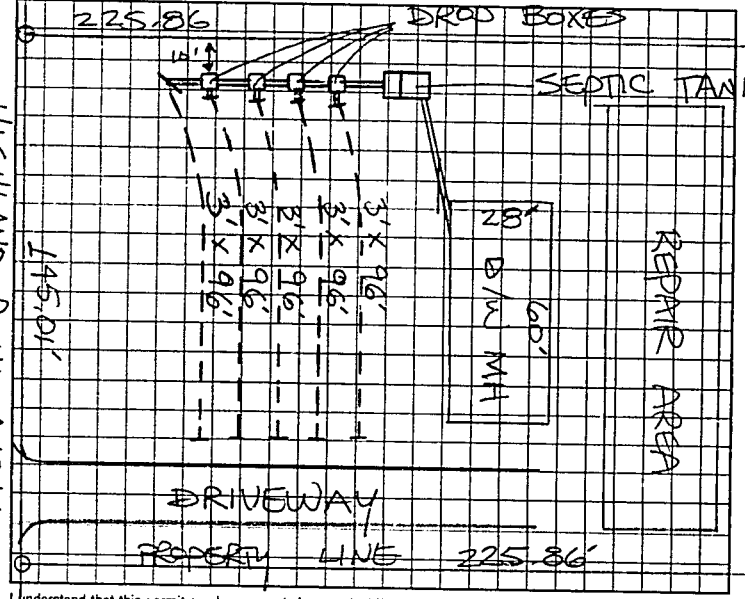

AS BUILT SKETCH

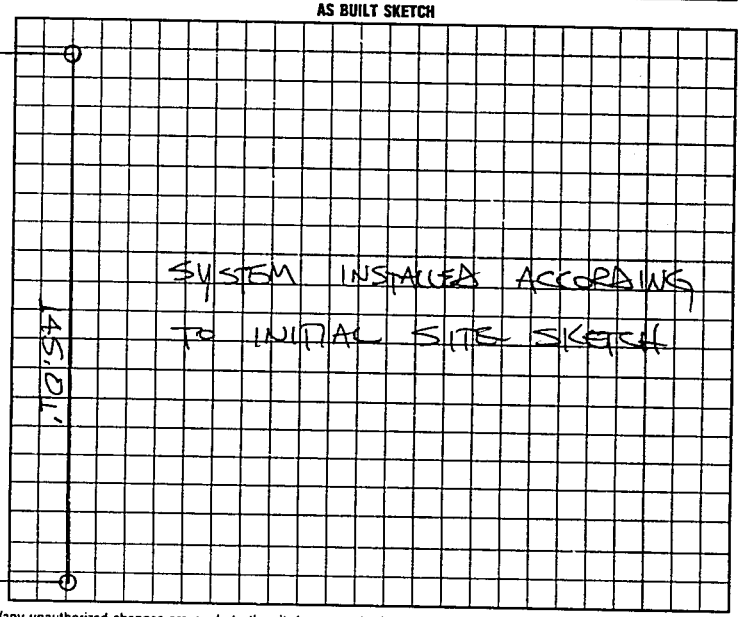

I understand that this permit can be suspended or revoked if any false information is supplied toward securing the permit/any unauthorized changes are made to the site/any unauthorized changes are made in the installation of the system. Improvement Permit is valid for 60 months from date of issuance.

Signed: John R. Hedrick

Improvement Permit by: STEVE HEDRICK date 9-25-95

Existing System Inspection by: _____ date _____

Installed by: SAMMY REALS

~~Certificate of Completion by: STEVE HEDRICK date 10-17-95~~

Operation Permit by: STEVE HEDRICK date 10-17-95

HEALTH DEPT. COPY: WHITE INSPECTION COPY (FINAL): GREEN OWNER COPY (FINAL): YELLOW INSPECTION COPY (INITIAL): PINK OWNER COPY (INITIAL): GOLD