IREDELL COUNTY HEALTH DEPARTMENT

STATESVILLE 704-878-5305 MOORESVILLE 704-664-5281

IMPROVEMENT PERMIT / AUTHORIZATION TO CONSTRUCT / OPERATION PERMIT / EXISTING SYSTEM INSPECTION

PERMIT# 26270 PIN# 4870 84 0098 DATE 2-5-98

OWNER OR CONTRACTOR JEFFREY & LYNN SAFLEY PHONE: Business Home 546-5813

ADDRESS 496 CRANFILL ROAD, HARMONY, NC 28634

LOCATION US 21 N, TR NC 901, TR CRANFILL ROAD, 0.6 MILE ON RIGHT

SUBDIVISION BLOCK / SECTION LOT LOT AREA 0.5 ACRE SITE CLASS. PS DESIGN FLOW 240 L.T.A.R. 0.25 GPD/FT²

Septic Tank: 1000 Gallons; STB 1017 Date 4-5-98
Pump Tank: Gallons; PT Date
Pump Make: Model Serial No.
Nitrification Field: No Fields 1 Square Feet 960 Linear Feet 320
No Lines FOUR Trench Width 36" Max Trench Bottom Depth 36" Gravel Depth 12"

☑ New System ☐ Repair System Type: I, II, III, IV, V, VI
System Description: CONVENTIONAL GRAVITY
Repair System Description: CONV. GRAVITY
Maintenance Agreement Required: ☐ Yes ☑ No

☐ House/Mod. Home ☑ Mobile Home ☐ Business ☐ Other
No. Bedrooms 2 No. Bathrooms 1½ No. Employees


☐ Slab ☑ Crawl Space ☐ Basement w/plumbing ☐ Basement wo/plumbing

Water Supply: ☐ Individual ☑ Public ☐ Community


Comments:/Conditions:

Comments:/Conditions:

INITIAL SITE SKETCH SCALE: 1"=40'

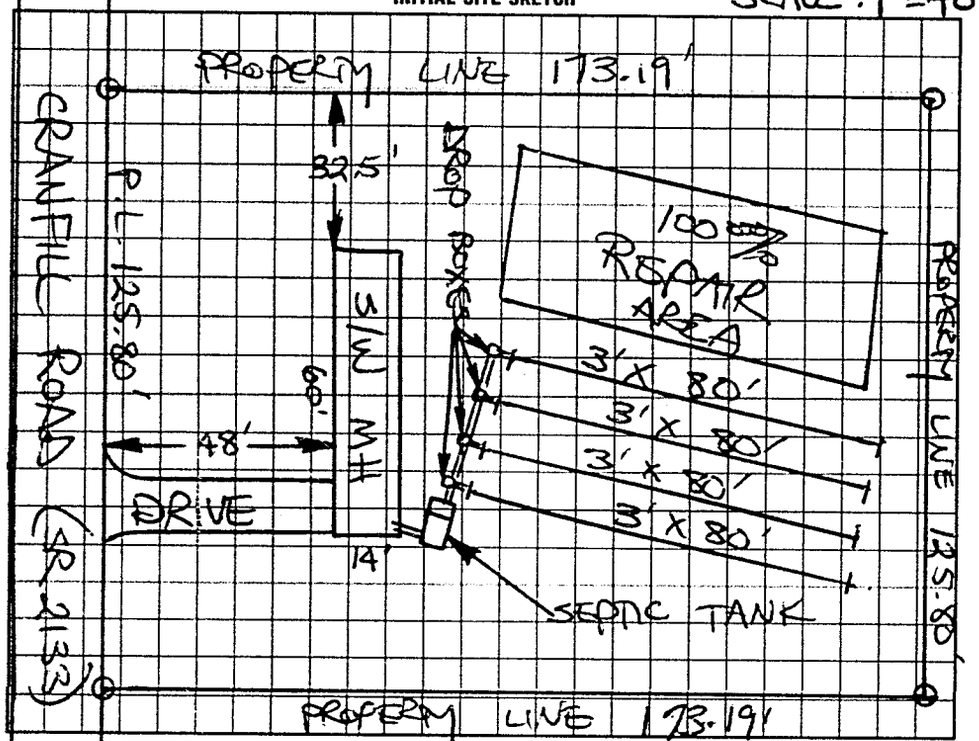

AS BUILT SKETCH

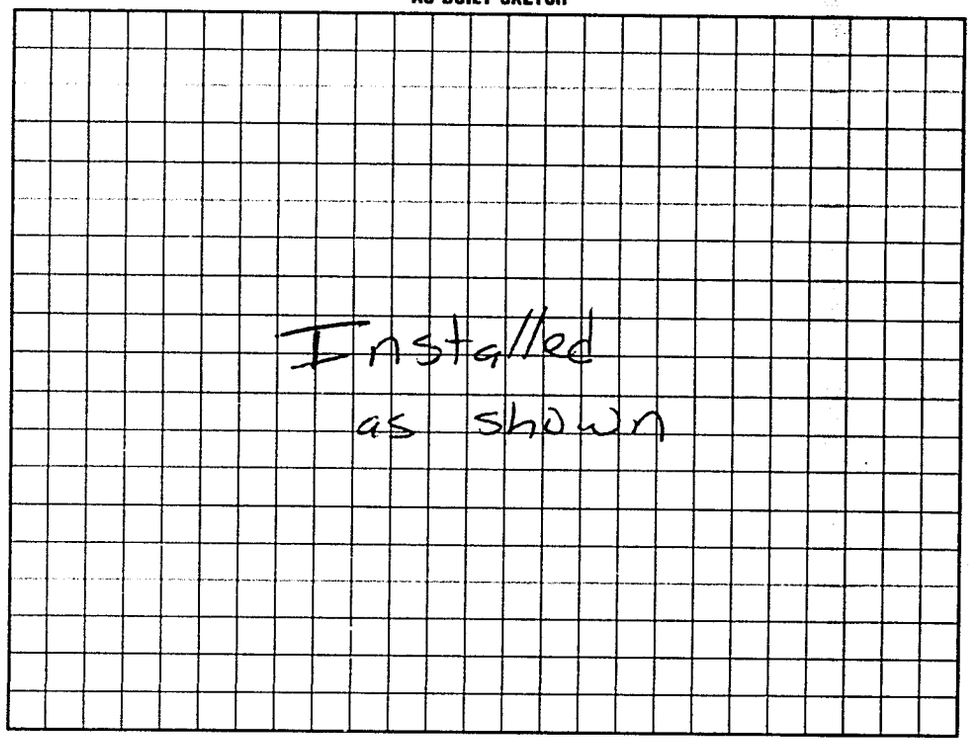

I understand that this permit can be suspended or revoked if any false information is supplied toward securing the permit/any unauthorized changes are made to the site/any unauthorized changes are made in the installation of the system. Improvement Permit with plat valid without expiration. Improvement Permit with site plan valid for sixty months. Authorization to Construct is valid for a period equal to that of Improvement Permit – not to exceed sixty months.

Signed: [signature] date 2-5-98

Improvement Permit by: STEVE HENDRICK date 2-5-98

Authorization to Construct by: STEVE HENDRICK date 2-5-98

Installed by: Tommy Frye

Operation Permit by: [signature] date 6-10-98

Existing System Inspection by: date

HEALTH DEPT. COPY: WHITE INSPECTION COPY (FINAL): GREEN OWNER COPY (FINAL): YELLOW INSPECTION COPY (INITIAL): PINK OWNER COPY (INITIAL): GOLD

5/0000