IREDELL COUNTY HEALTH DEPARTMENT

STATESVILLE 704-878-5305 MOORESVILLE 704-664-5281

IMPROVEMENT PERMIT / AUTHORIZATION TO CONSTRUCT / OPERATION PERMIT / EXISTING SYSTEM INSPECTION

PERMIT# 92347 PIN# 4870 83 5275 DATE 10-10-00

OWNER OR CONTRACTOR Lynn Safley PHONE: Business Home 546 5813

ADDRESS 496 Cranfill Rd Harmony, N.C.

LOCATION 21N TR 901 TR Cranfill 1/2 mile Rd

SUBDIVISION Safley manor BLOCK / SECTION LOT 1 LOT AREA .15 acres SITE CLASS. P5 DESIGN FLOW 240 L.T.A.R. .33

Septic Tank: 1000 Gallons; STB 760 Date 9-16-00
Pump Tank: Gallons; PT Date
Pump Make: Model Serial No.
Nitrification Field: No Fields 1 Square Feet 720 Linear Feet 240
No Lines 3 Trench Width 36" Max Trench Bottom Depth 36" Gravel Depth 12"

☒ New System ☐ Repair System Type: I II III IV V VI
System Description: Conv. Gravity
Repair System Description: " "
Maintenance Agreement Required: ☐ Yes ☒ No


☐ House/Mod. Home No. Bedrooms 2
☒ Mobile Home No. Bathrooms 1 1/2
☐ Business No. Employees
☐ Other
☐ Slab ☒ Crawl Space ☐ Basement w/plumbing ☐ Basement wo/plumbing

Water Supply: ☐ Individual ☒ Public ☐ Community


Comments/Conditions:

Comments/Conditions: SEPTIC TANK WITH MARKER INSTALLED USING "ZABEL" FILTER
System Approved For 360 GPD

INITIAL SITE SKETCH

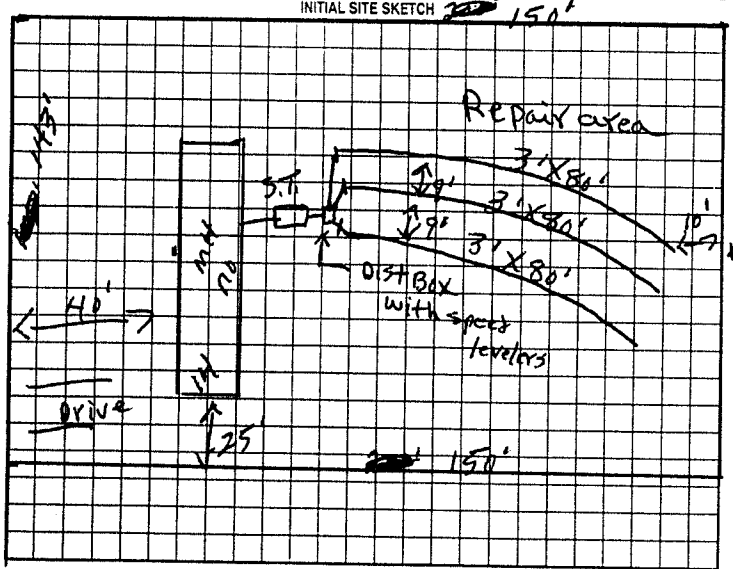

AS BUILT SKETCH

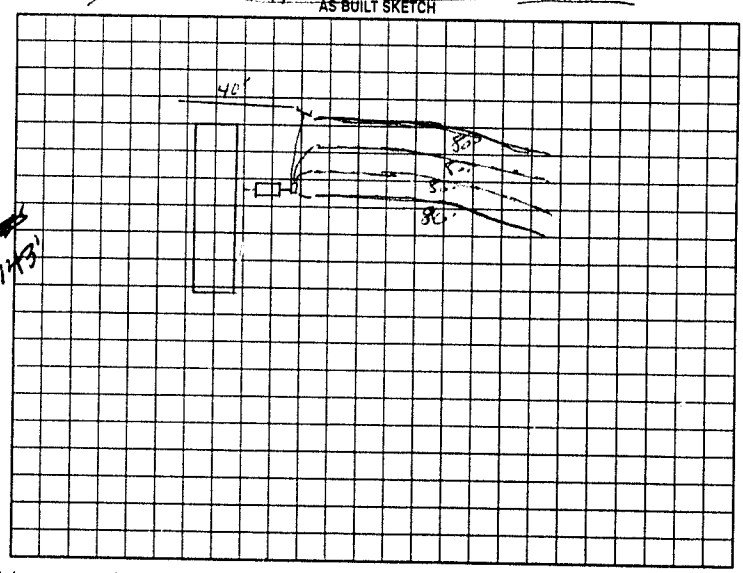

Permit can be suspended or revoked if any false information is supplied toward securing the permit/any unauthorized changes are made to the site/any unauthorized changes are made in the installation of the system. Improvement Permit with plat valid without expiration. Improvement Permit with site plan valid for sixty months. Authorization to Construct is valid for a period equal to that of Improvement Permit – not to exceed sixty months.

Signed: Lynn R Safley Sr. date 10-10-00 Installed by: BRENT GALLIHER

Improvement Permit by: R. C. Moore date 10-10-00 Operation Permit by: Gary McNeil RSI date 11/22/00

Authorization to Construct by: R. C. Moore date 10-10-00 Existing System Inspection by: date

HEALTH DEPT. COPY: WHITE OWNER COPY (FINAL): YELLOW OWNER COPY (INITIAL): PINK