IREDELL COUNTY HEALTH DEPARTMENT

STATESVILLE 704-878-5305 MOORESVILLE 704-664-5281

IMPROVEMENT PERMIT / AUTHORIZATION TO CONSTRUCT / OPERATION PERMIT / EXISTING SYSTEM INSPECTION

PERMIT# 14243 PIN# 4870839827 DATE 7-30-07

OWNER OR APPLICANT Charles & Bonnie Gunter PHONE: Business _____ Home 336 492-2001

ADDRESS 450 Gunter Law Harmony NC

LOCATION 21N - (R) 901 (R) CRAWFORD RD (R) Gunter #450 Gunter Lane Lot 109

SUBDIVISION _____ BLOCK / SECTION _____ LOT ~~#~~ _____ LOT AREA 25,175 ft² SITE CLASS. PS DESIGN FLOW 240 L.T.A.R. .33

Septic Tank: 1000 Gallons; STB 760 Date 7-27
Pump Tank: _____ Gallons; PT _____ Date _____
Pump Make: _____ Model _____ Serial No. _____
Nitrification Field: No Fields ___ Square Feet 720 Linear Feet 240
No Lines 3 Trench Width _____ Max Trench Bottom Depth 18-30 Gravel Depth _____ ☐ Gravity ☐ Pressure

☐ New System ☐ Repair ☐ Expansion System Type: I (II) III IV V VI
System Description: Exist Conv - Gravity
Repair System Description: Conv Gravity
Maintenance Agreement Required: ☐ Yes ☐ No

☐ House/Mod. Home ☐ Mobile Home ☐ Business ☐ Other _____
No. Bedrooms 2 No. Persons _____ No. Employees _____

Water Supply: ☐ Individual ☐ Public ☐ Community


☐ Slab ☐ Crawl Space ☐ Basement w/plumbing ☐ Basement wo/plumbing

Comments:/Conditions:


New Home not to exceed 2 Bedrooms

Comments:/Conditions:

INITIAL SITE SKETCH

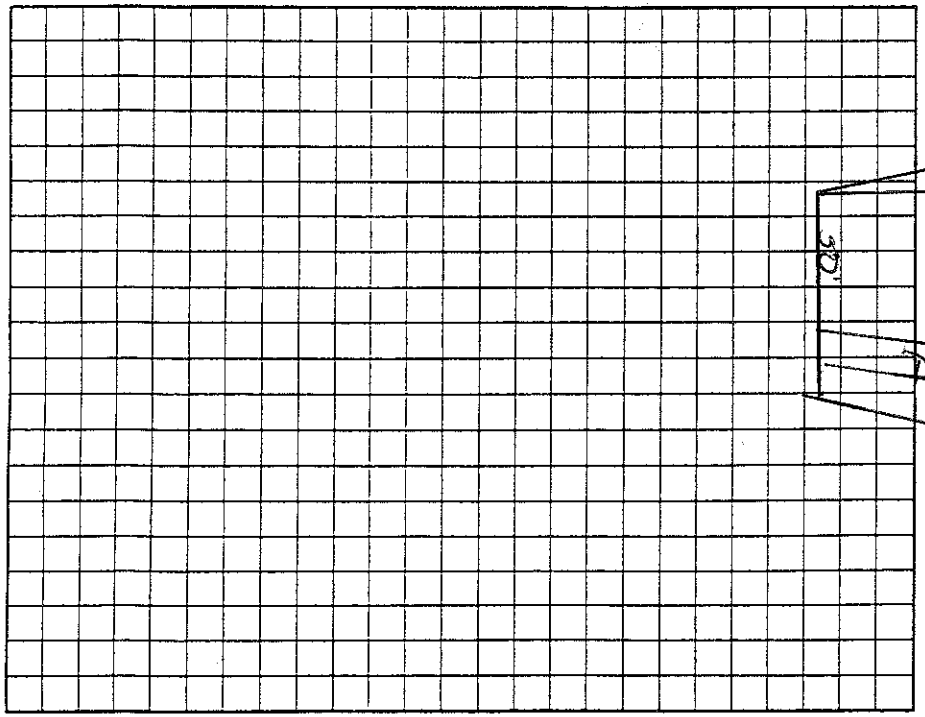

AS BUILT SKETCH

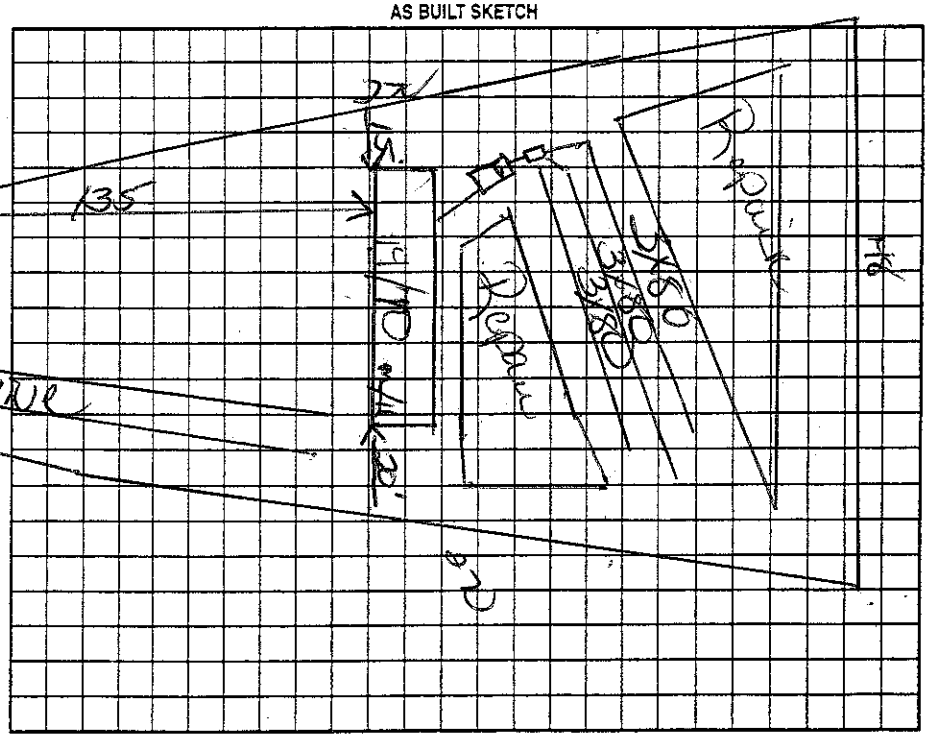

Permit can be suspended or revoked if any false information is supplied toward securing the permit/any unauthorized changes are made to the site/any unauthorized changes are made in the installation of the system. Improvement Permit with plat valid without expiration ☐ Improvement Permit with site plan valid for sixty months ☐ Authorization to Construct is valid for a period equal to that of Improvement Permit – not to exceed sixty months.

Signed: _____ date _____

Improvement Permit by: _____ date _____

Authorization to Construct by: _____ date _____

Installed by: _____

Operation Permit by: _____ date _____

Existing System Inspection by: Keith Cook date 7-31-07

HEALTH DEPT. COPY: WHITE OWNER COPY (FINAL): YELLOW OWNER COPY (INITIAL): PINK