IREDELL COUNTY HEALTH DEPARTMENT

STATESVILLE 704-878-5305 MOORESVILLE 704-664-5281

IMPROVEMENT PERMIT / AUTHORIZATION TO CONSTRUCT / OPERATION PERMIT / EXISTING SYSTEM INSPECTION

PERMIT# 071733 PIN# 4870 85 1708 DATE 2-5-98

OWNER OR CONTRACTOR VINSON DEHAVEN PHONE: Business C-21/8732121 Home

ADDRESS C/O C-21, 1805 SAFRIET ROAD, STATESVILLE, NC 28625

LOCATION US 21 N, TR NC 901, ON RIGHT ACROSS FROM LINDA DRIVE

SUBDIVISION BLOCK / SECTION LOT LOT AREA 1.07 ACRE SITE CLASS PS DESIGN FLOW 480 L.T.A.R. 0.33 GPD/FT²

Septic Tank: 1000 Gallons; STB 1012 Date 12-3-97

Pump Tank: Gallons; PT Date

Pump Make: Model Serial No.

Nitrification Field: No Fields 1 Square Feet 1440 Linear Feet 480

No Lines FOUR Trench Width 36" Max Trench Bottom Depth 36" Gravel Depth 12"

☑ New System ☐ Repair System Type: I, II, III, IV, V, VI

System Description: CONVENTIONAL GRAVITY

Repair System Description: CONV. GRAVITY

Maintenance Agreement Required: ☐ Yes ☑ No

☐ Slab ☑ Crawl Space ☐ Basement w/plumbing ☐ Basement wo/plumbing

☐ House/Mod. Home ☑ Mobile Home ☐ Business ☐ Other


No. Bedrooms 4 No. Bathrooms 3 No. Employees

Water Supply: ☐ Individual ☑ Public ☐ Community

Comments:/Conditions:

PROPERTY LINE 235'

INITIAL SITE SKETCH SCALE: 1"=50'

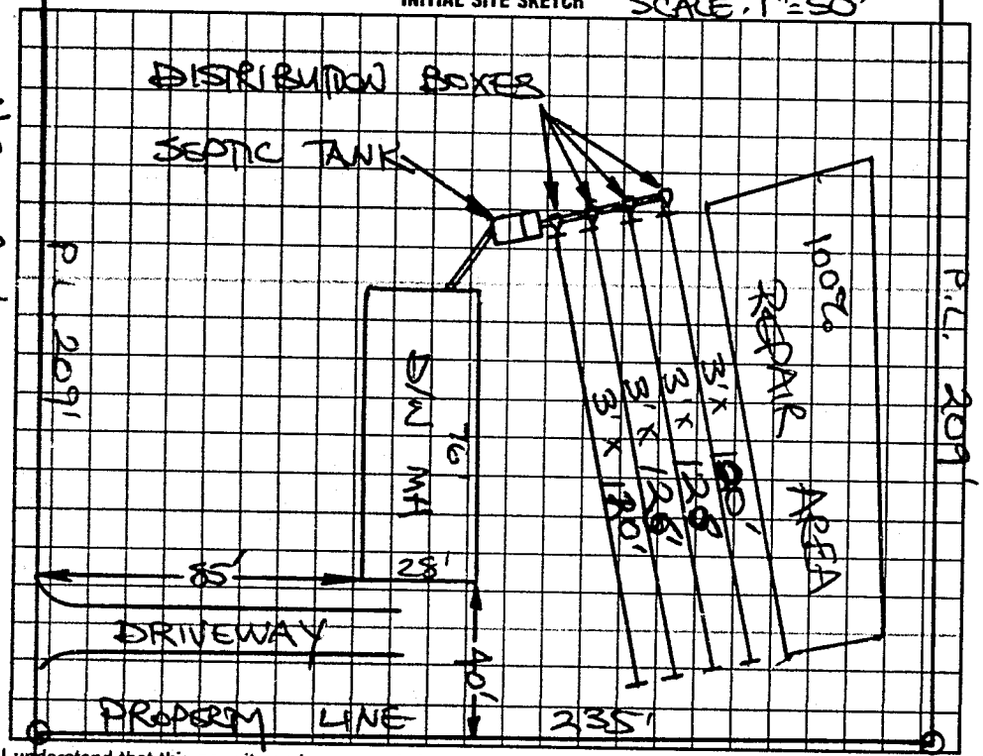

Comments:/Conditions:

AS BUILT SKETCH

Installed as shown

NC 901

I understand that this permit can be suspended or revoked if any false information is supplied toward securing the permit/any unauthorized changes are made to the site/any unauthorized changes are made in the installation of the system. Improvement Permit with plat valid without expiration. Improvement Permit with site plan valid for sixty months. Authorization to Construct is valid for a period equal to that of Improvement Permit – not to exceed sixty months.

Signed: Edward Mitchell date

Improvement Permit by: STEVE HEDRICK date 2-5-98

Authorization to Construct by: STEVE HEDRICK date 2-5-98

Installed by: A-1 Backhoe

Operation Permit by: Mark C. Oaks, RS date 3-11-98

Existing System Inspection by: date

HEALTH DEPT COPY WHITE INSPECTION COPY (FINAL) GREEN OWNER COPY (FINAL) YELLOW INSPECTION COPY (INITIAL) PINK OWNER COPY (INITIAL) GOLD