IREDELL COUNTY HEALTH DEPARTMENT

STATESVILLE 704-878-5305 MOORESVILLE 704-664-5281

PD 320.00 TOTAL

IMPROVEMENT PERMIT / AUTHORIZATION TO CONSTRUCT / OPERATION PERMIT / EXISTING SYSTEM INSPECTION

PERMIT# HARMONY PIN# 4870 86 1114

OWNER OR CONTRACTOR JOHN WOOTEN PHONE: Business Home (336) 449-9080 DATE 4-24-98

ADDRESS 237 EAST MEMORIAL HIGHWAY HARMONY, NC 28634

LOCATION US 21 N; TR NC 901, TL LINDA DRIVE, 1ST LOT ON RIGHT

SUBDIVISION BLOCK / SECTION LOT 1114 LOT AREA 122' X 405' SITE CLASS. RS DESIGN FLOW 360 L.T.A.R. 0.30 GPD/FT²

Septic Tank: 1000 Gallons; STB 928 Date 7-17-98

Pump Tank: Gallons; PT Date

Pump Make: Model Serial No.

Nitrification Field: No Fields 1 Square Feet EQ. TO 1200 Linear Feet 300

No Lines FIVE Trench Width 36" Max Trench Bottom Depth 36" ~~Gravel~~ Depth 6" SAND

☑ New System ☐ Repair System Type: I, II, (III), IV, V, VI

System Description: CHAMBERED GRAVITY

Repair System Description: MAX. FEASIBLE AREA

Maintenance Agreement Required: ☐ Yes ☑ No

☐ House/Mod. Home ☑ Mobile Home ☐ Business ☐ Other

No. Bedrooms 3 No. Bathrooms 2 No. Employees


Water Supply: ☐ Individual ☑ Public ☐ Community

☐ Slab ☑ Crawl Space ☐ Basement w/plumbing ☐ Basement wo/plumbing


Comments:/Conditions: ① NO CUTTING OF SOIL ALLOWED FOR MH SETUP — NATURAL GRADE ONLY ② INSTALL FIFTY (50) CHAMBERS IN FIVE LINES ON CONTOUR ③ LANDSCAPE AND SOW GRASS AFTER INSTALLATION

Comments:/~~Conditions:~~ SYSTEM INSTALLED ACCORDING TO INITIAL SITE SKETCH

INITIAL SITE SKETCH SCALE: 1"=40'

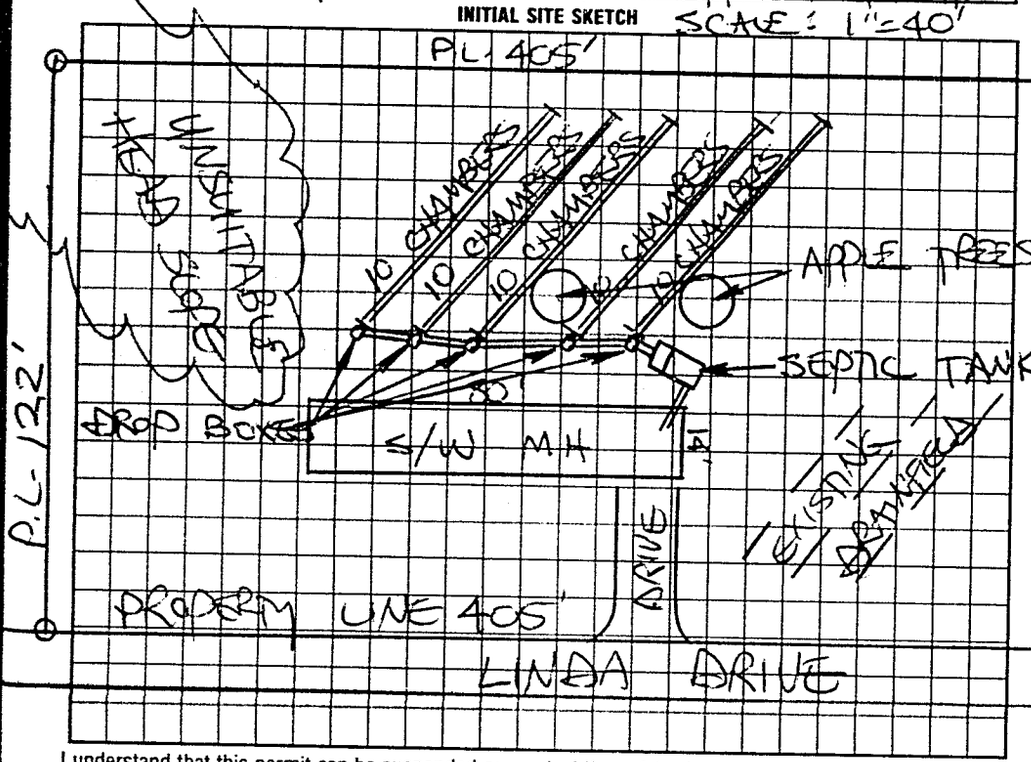

AS BUILT SKETCH

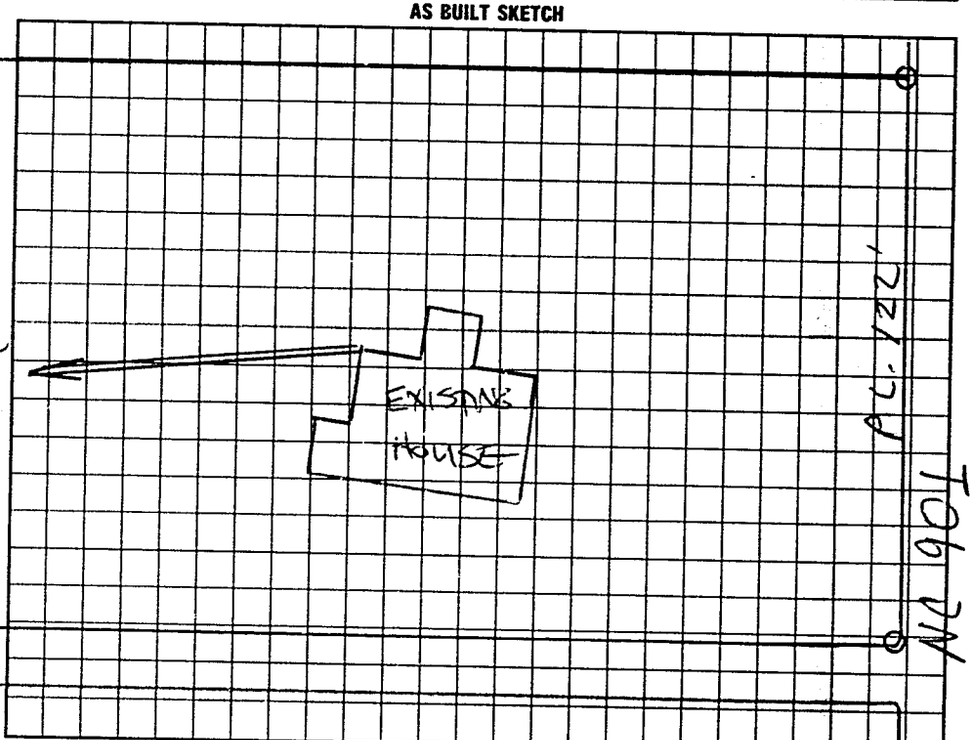

I understand that this permit can be suspended or revoked if any false information is supplied toward securing the permit/any unauthorized changes are made to the site/any unauthorized changes are made in the installation of the system. Improvement Permit with plat valid without expiration. Improvement Permit with site plan valid for sixty months. Authorization to Construct is valid for a period equal to that of Improvement Permit – not to exceed sixty months.

Signed: John H Wooten date 4-24-98 Installed by: SAMMY REAVIS

Improvement Permit by: STEVE HEDRICK date 4-24-98 Operation Permit by: STEVE HEDRICK date 8-5-98

Authorization to Construct by: STEVE HEDRICK date 4-24-98 Existing System Inspection by: date

HEALTH DEPT. COPY: WHITE INSPECTION COPY (FINAL): GREEN OWNER COPY (FINAL): YELLOW INSPECTION COPY (INITIAL): PINK OWNER COPY (INITIAL): GOLD