IREDELL COUNTY HEALTH DEPARTMENT

STATESVILLE 704-878-5305 MOORESVILLE 704-664-5281

IMPROVEMENT PERMIT / CERTIFICATE OF COMPLETION / OPERATION PERMIT / EXISTING SYSTEM INSPECTION

PROPERTY DESCRIPTION NO. 2457 | DATE 7-29-96 | TAX MAP NO. 12N-A-189 (PART) | Watershed: ~~TH Bow~~ No

OWNER OR CONTRACTOR HARMONY PROPERTIES | PHONE: Business | Home 532-6527

ADDRESS 5551 MONROE ROAD, CHARLOTTE, NC 28212

LOCATION US 21 N, TR TOMLINSON AVE, TR REDMAN RD TR PEPPERTREE, TR CEDARVALE DRIVE

SUBDIVISION SAGEFIELD | BLOCK / SECTION II | LOT 25 | LOT AREA 0.767 AC | SITE CLASS PS | DESIGN FLOW 360 | L.T.A.R. 0.3 GAD/FT²

Septic Tank: 1000 Gallons; STB 794 Date 6-10-96
Pump Tank: ____ Gallons; PT ____ Date ____
Pump Make: ____ Model ____ Serial No. ____
Nitrification Field: No Fields 1 Square Feet 1200 Linear Feet 400
No Lines 5 Trench Width 36" Max Trench Bottom Depth 18-24" Gravel Depth 12"

☑ New System ☐ Repair System Type: I II, IV, V, VI
System Description: CONV. GRAVITY
Repair System Description: CHAMBERED PUMP
Maintenance Agreement Required: ☐ Yes ☑ No

☐ House/Mod. Home ☑ Mobile Home ☐ Business ☐ Other
No. Bedrooms 3 No. Bathrooms 2 No. Employees ____

☐ Slab ☑ Crawl Space ☐ Basement w/plumbing ☐ Basement wo/plumbing


Water Supply: ☐ Individual ☐ Community ☑ Public

Comments: ① INSTALL FIVE LINES ON CONTOUR USING SERIAL DISTRIBUTION. ② KEEP SYSTEM MINIMUM 5' FROM MH, 10' FROM PROPERTY LINE, 10' FROM WATER LINE


Comments:

3RD LOT ON RIGHT

INITIAL SITE SKETCH

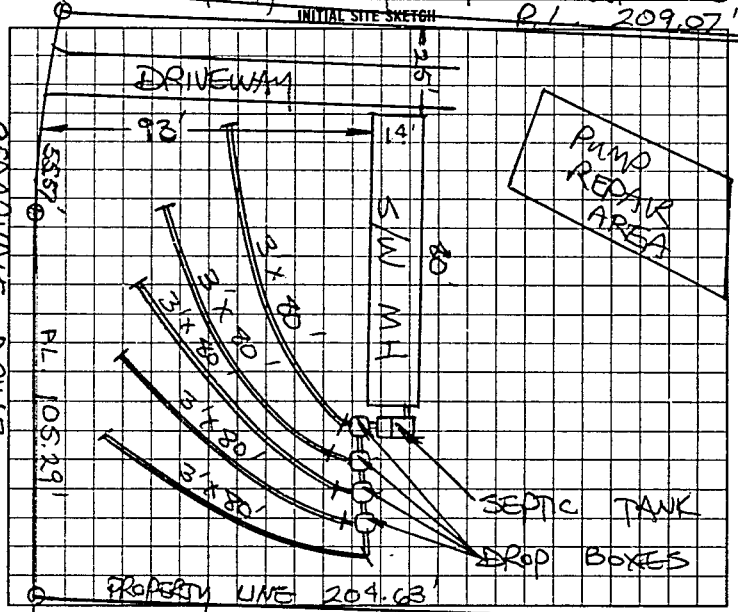

AS BUILT SKETCH

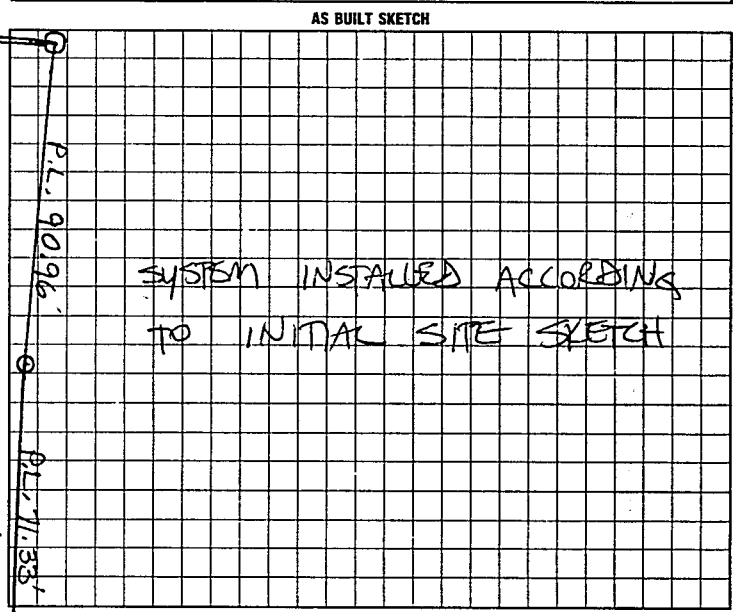

I understand that this permit can be suspended or revoked if any false information is supplied toward securing the permit(s) unauthorized changes are made to the site/any unauthorized changes are made in the installation of the system.

AUTH. TO CONST. IS VALID FOR FIVE YEARS FROM DATE OF ISSUANCE. IMPROVEMENT PERMIT WITH SITE PLAN IS VALID FOR FIVE YEARS.

Signed: James J. Barkley

Installed by: A-1 BACKHOE

Improvement Permit by: STEVE HEDRICK date 7-29-96

~~Certificate of Completion by:~~ ____ date ____

AUTH. TO CONST. ~~Following System Inspection~~ by: STEVE HEDRICK date 7-29-96

Operation Permit by: STEVE HEDRICK date 8-14-96

HEALTH DEPT. COPY: WHITE | INSPECTION COPY (FINAL): GREEN | OWNER COPY (FINAL): YELLOW | INSPECTION COPY (INITIAL): PINK | OWNER COPY (INITIAL): GOLD

9 L S 0 0 0