IREDELL COUNTY HEALTH DEPARTMENT

Statesville Office (704) 878-5305 Mooresville Office (704) 660-3625 PERMIT # 208430

IMPROVEMENT PERMIT / AUTHORIZATION TO CONSTRUCT / OPERATION PERMIT / EXISTING SYSTEM

PIN # 4870871926

APPLICANT: Jimmy + Kimberly Kelly APPLICANT ADDRESS: 150 Thomas Rock Dr Harmony NC 28634

SITE ADDRESS: 126 Cedarvale Dr Harmony NC 28634 PHONE: 304-308-7125 ALT. PHONE: N/A


SITE DIRECTIONS: Hwy 21 T/R Highland T/R Peppertree T/R Cedarvale property on Right

SUBDIVISION: Sagefield SECTION: Perm LOT # 25 LOT AREA: 0.77ac DESIGN FLOW: 360 L.T.A.R.: Ex


Septic Tank	Ex	(gal)	STB		Date		☐ New System	☐ Repair	☐ Expansion	System Type: I II III IV V VI	☒ Residence	No. Bedrooms	3	Water Supply	
Pump Tank		(gal)	PT		Date		System Description:	Existing			☐ Business	No. Persons	6	☐ Private	
Pump Make		Model			Serial #		Repair System Description:				☐ Other	No. Employees		☒ Public	
# Nitrification Fields	Ex	# Lines	Ex		Linear Ft:	Ex	Maintenance Agreement Required:	☐ YES	☒ NO		☐ Slab	☒ Crawl Space		☐ Community	
Trench Width	Ex	Max. Trench Bottom Depth	Ex		Gravel Depth	Ex		☒ GRAVITY	☐ PRESSURE		☐ Basement w/plumbing		☐ Basement w/o plumbing		

Comments / Conditions: All building foundations must be 35' from any

INITIAL SITE SKETCH

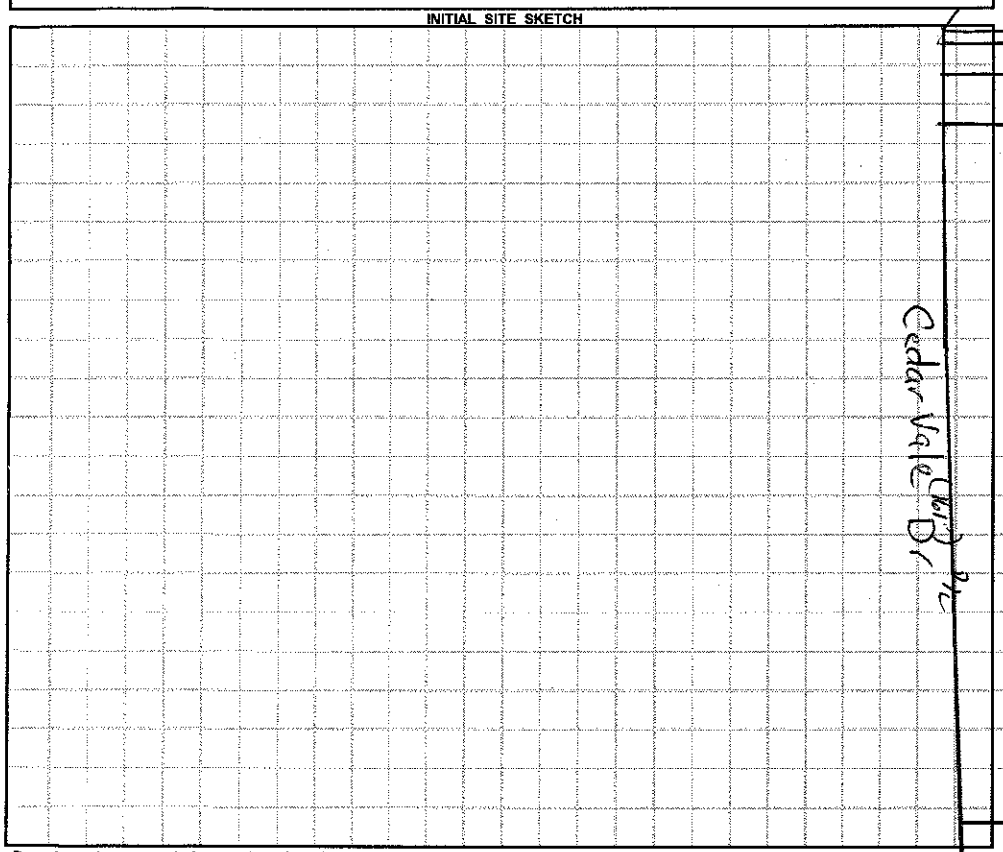

AS BUILT SKETCH

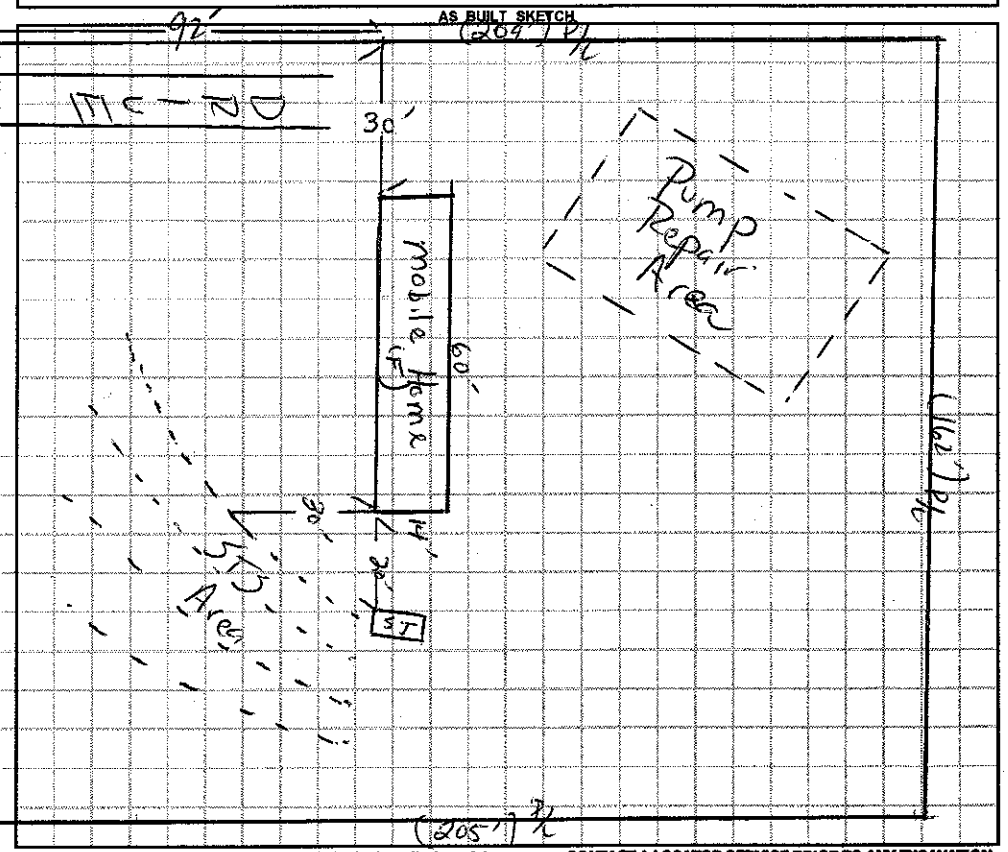

Permit can be suspended or revoked if any false information is supplied toward securing the permit / any unauthorized changes are made to the site / any unauthorized changes are made in the installation of the system. **CONTACT A LOCATOR SERVICE PRIOR TO ANY EXCAVATION**

☐ **IMPROVEMENT PERMIT** *with plat valid without expiration.* ☐ **IMPROVEMENT PERMIT** *with site plan valid for 60 mos.* ☐ **AUTHORIZATION TO CONSTRUCT** *valid for period equal to IMPROVEMENT PERMIT--not to exceed 60 mo.*

Owner / Applicant Signature: Jimmy R. Kelly Date: 3/3/15 Installed by:

IMPROVEMENT PERMIT by: Date: OPERATION PERMIT by: Date:

AUTHORIZATION TO CONSTRUCT by: Date: Existing System Inspected by: Date: 03/03/15

Health Dept. Copy - WHITE Applicant (Final Approval) - YELLOW Applicant (Conditional Approval) - PINK