IREDELL COUNTY HEALTH DEPARTMENT

STATESVILLE 704-878-5305 MOORESVILLE 704-664-5281 (21)

IMPROVEMENT PERMIT / AUTHORIZATION TO CONSTRUCT / OPERATION PERMIT / EXISTING SYSTEM INSPECTION

PERMIT# 113699 PIN# 4870-87-3936 DATE 6-11-03

OWNER OR CONTRACTOR HARMONY PROPERTIES PHONE: Business 704-532-6625 Home 704-872-0179

ADDRESS 5551 MONROE ROAD, CHARLOTTE NC 28212

LOCATION US 21 N, TR TOMLINSON AVE, TR REDMON TR PEPPERTREE TR CEDARVALE DR, 2ND LOT ON RIGHT

SUBDIVISION SAGEFIELD BLOCK / SECTION II LOT 24 LOT AREA 1.172 ACRES SITE CLASS. PS DESIGN FLOW 360 L.T.A.R. 0.30 GPD/FT²

Septic Tank: 1000 Gallons; STB ____ Date ____

Pump Tank: ____ Gallons; PT ____ Date ____

Pump Make: ____ Model ____ Serial No. ____

Nitrification Field: No Fields 1 Square Feet 1200 Linear Feet 400

No Lines FIVE Trench Width 36" Max Trench Bottom Depth ____ Gravel Depth 12"

☐ New System ☐ Repair System Type: I, (II), III, IV, V, VI

System Description: CONVENTIONAL GRAVITY

Repair System Description: ____

Maintenance Agreement Required: ☐ Yes ☑ No

☐ House/Mod. Home ☑ Mobile Home ☐ Business ☐ Other

No. Bedrooms 3 No. Bathrooms 2 No. Employees ____

☐ Slab ☑ Crawl Space ☐ Basement w/plumbing ☐ Basement wo/plumbing


Water Supply: ☐ Individual ☑ Public ☐ Community

Comments:/Conditions:

INITIAL SITE SKETCH

Comments:/Conditions: KEEP MH MINIMUM 5 FEET FROM SYSTEM

AS BUILT SKETCH

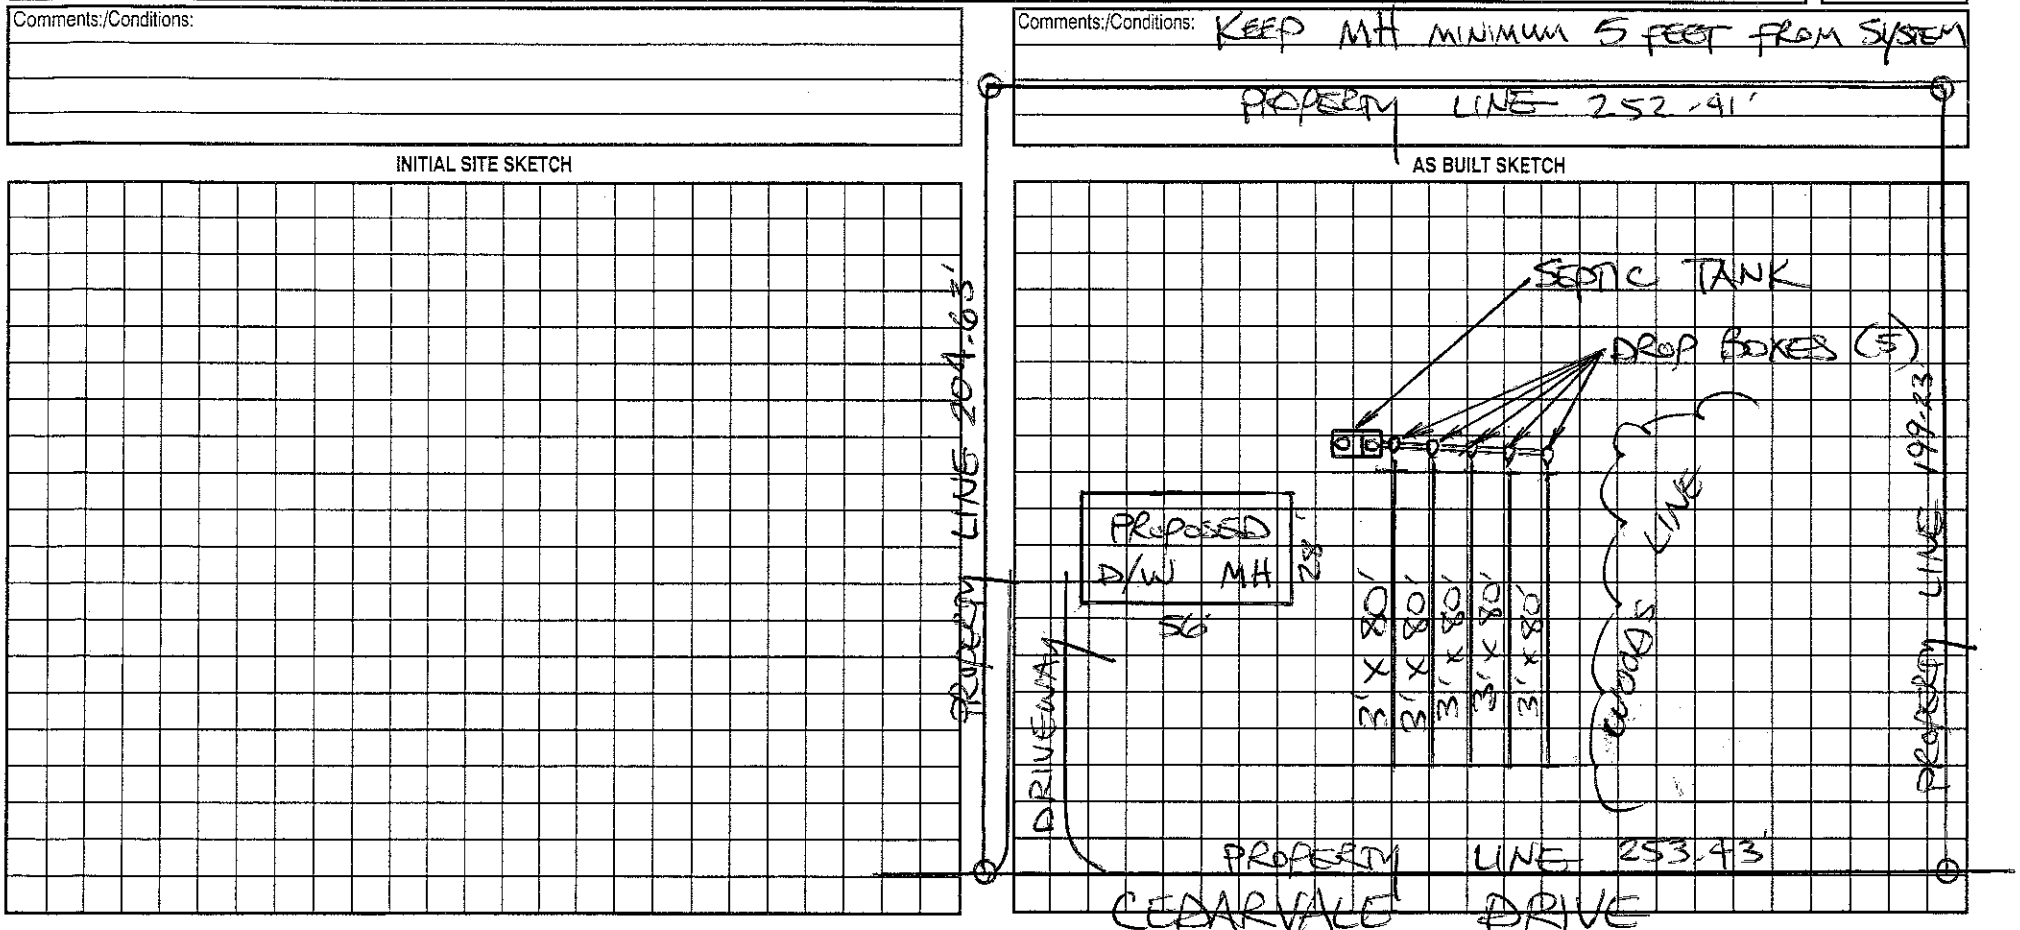

Permit can be suspended or revoked if any false information is supplied toward securing the permit/any unauthorized changes are made to the site/any unauthorized changes are made in the installation of the system. Improvement Permit with plat valid without expiration. Improvement Permit with site plan valid for sixty months. Authorization to Construct is valid for a period equal to that of Improvement Permit – not to exceed sixty months.

Signed: ____ date ____ Installed by: ____

Improvement Permit by: ____ date ____ Operation Permit by: ____ date ____

Authorization to Construct by: ____ date ____ Existing System Inspection by: STEVE HEDRICK date 6-11-03

HEALTH DEPT. COPY: WHITE OWNER COPY (FINAL): YELLOW OWNER COPY (INITIAL): PINK