IREDELL COUNTY HEALTH DEPARTMENT

STATESVILLE 704-878-5305 MOORESVILLE 704-664-5281

IMPROVEMENT PERMIT / AUTHORIZATION TO CONSTRUCT / OPERATION PERMIT / EXISTING SYSTEM INSPECTION

PERMIT# 078732 PIN# 4870 87 3936 DATE 1-20-99

OWNER OR CONTRACTOR HARMONY PROPERTIES PHONE: Business (704) 532-6527 Home

ADDRESS 5551 MONROE ROAD, CHARLOTTE, NC 28212

LOCATION US 21 N, TR HIGHLAND POINT, TR REDMON, TR PEPPERTREE, TR CEDARVALE, 2ND LOT ON RIGHT

SUBDIVISION SAGEFIELD BLOCK / SECTION II LOT 24 LOT AREA 1.172 ACRES SITE CLASS PS DESIGN FLOW 360 L.T.A.R. 0.33 GPD/FT²

Septic Tank: 1000 Gallons; STB 786 Date 12-16-98
Pump Tank: Gallons; PT Date
Pump Make: Model Serial No.
Nitrification Field: No Fields 1 Square Feet 1080 Linear Feet 360
No Lines SIX Trench Width 36" Max Trench Bottom Depth 36" Gravel Depth 12"

☑ New System ☐ Repair System Type: ☐ II. ☐ III. ☐ IV. ☐ V. ☐ VI
System Description: CONVENTIONAL GRAVITY
Repair System Description: CONV. GRAVITY
Maintenance Agreement Required: ☐ Yes ☑ No
☐ Slab ☑ Crawl Space ☐ Basement w/plumbing ☐ Basement wo/plumbing


☐ House/Mod. Home No. Bedrooms 3
☑ Mobile Home No. Bathrooms 2
☐ Business No. Employees
☐ Other

Water Supply: ☐ Individual ☑ Public ☐ Community

Comments/Conditions: SCALE: 1"=50'

Comments/Conditions: "ZABEL" FILTER INSTALLED AT OUTLET OF SEPTIC TANK

INITIAL SITE SKETCH

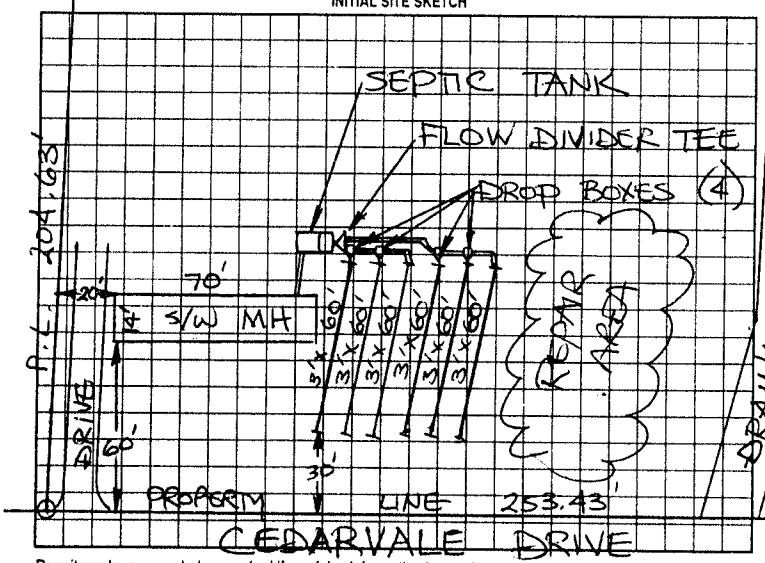

AS BUILT SKETCH

SYSTEM INSTALLED ACCORDING TO INITIAL SITE SKETCH

Permit can be suspended or revoked if any false information is supplied toward securing the permit/any unauthorized changes are made to the site/any unauthorized changes are made in the installation of the system. Improvement Permit with plat valid without expiration. Improvement Permit with site plan valid for sixty months. Authorization to Construct is valid for a period equal to that of Improvement Permit - not to exceed sixty months.

Signed: [signature] date 1-20-99 Installed by: G & M ENTERPRISES

Improvement Permit by: STEVE HEDRICK date 1-20-99 Operation Permit by: STEVE HEDRICK date 2-8-99

Authorization to Construct by: STEVE HEDRICK date 1-20-99 Existing System Inspection by: date

HEALTH DEPT. COPY: WHITE OWNER COPY (FINAL): YELLOW OWNER COPY (INITIAL): PINK