IREDELL COUNTY HEALTH DEPARTMENT

STATESVILLE 704-878-5305 MOORESVILLE 704-664-5281

IMPROVEMENT PERMIT / CERTIFICATE OF COMPLETION / OPERATION PERMIT / EXISTING SYSTEM INSPECTION

PROPERTY DESCRIPTION NO. 24988 DATE 11-30-96 TAX MAP NO. 12N-A-189 Watershed: ☐ Yes ☑ No

OWNER OR CONTRACTOR HARMONY PROPERTIES PHONE: Business 532-6527 Home 532-6625 / 589-2842 MOBILE

ADDRESS 5551 MONROE ROAD CHARLOTTE, NC 28212

LOCATION US 21 N, TR HIGHLAND PARK, TR REDMOND, TR PEPPERTREE, 3RD LOT ON RIGHT

SUBDIVISION SAGEFIELD BLOCK / SECTION II LOT 23 LOT AREA SITE CLASS. PS DESIGN FLOW 360 L.T.A.R. 0.3 GPD/FT2

Septic Tank: 1000 Gallons; STB 821 Date 11-11-97 ☑ New System ☐ Repair System Type: I, II, (III) IV, V, VI

Pump Tank: Gallons; PT Date

Pump Make: Model Serial No.

Nitrification Field: No Fields 1 Square Feet EQ TO 1200 Linear Feet 300+

No Lines FOUR Trench Width 36" Max Trench Bottom Depth 36" Gravel Depth N/A

System Description: CHAMBERED GRAVITY

Repair System Description: CHAMBERED PUMP

Maintenance Agreement Required: ☐ Yes ☑ No

☐ House/Mod. Home No. Bedrooms 3

☑ Mobile Home No. Bathrooms 2

☐ Business No. Employees

☐ Other


☐ Slab ☑ Crawl Space ☐ Basement w/plumbing ☐ Basement wo/plumbing

Water Supply: ☐ Individual ☐ Community ☑ Public


Comments: INSTALL 50 CHAMBERS IN FOUR LINES AS FLAGGED.

Comments:

INITIAL SITE SKETCH

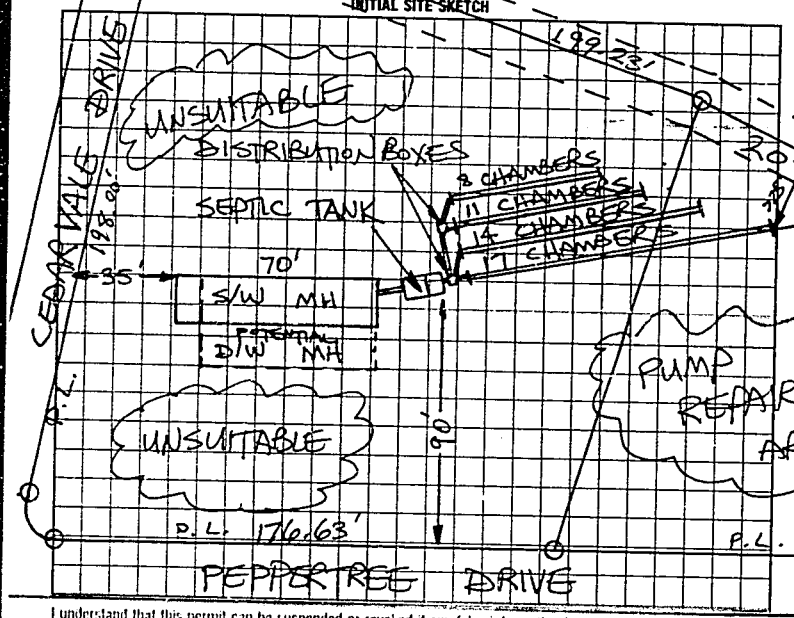

AS BUILT SKETCH

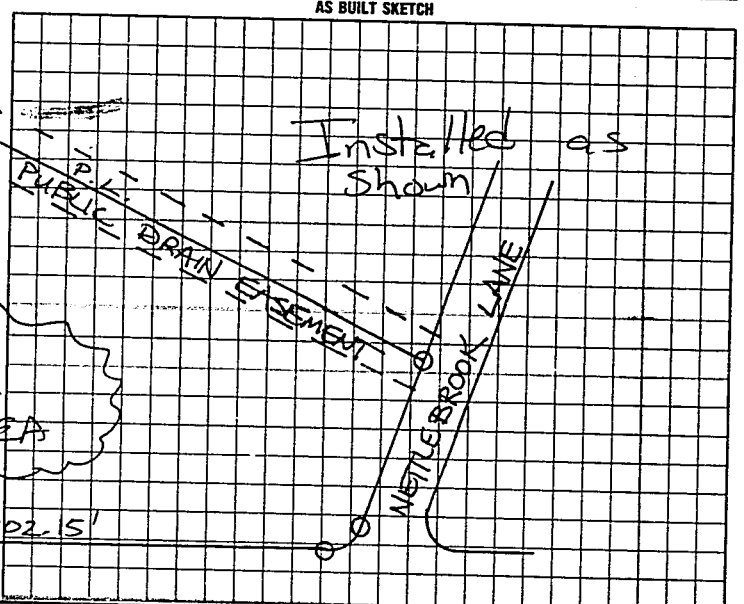

I understand that this permit can be suspended or revoked if any false information is supplied toward securing the permit/any unauthorized changes are made to the site/any unauthorized changes are made in the installation of the system.

Auth. to Const. is valid for a period equal to the validity of the IP not to exceed five years. IP w/site plan is valid five years.

Signed:

Improvement Permit by: STEVE HEDRICK date 11-30-96 Installed by: G+M Enterprises

Authorization to Construct XXXXXXXXXXXXXXXX by: STEVE HEDRICK date 11-30-96 Certificate of Completion by: date

Operation Permit by: RS date 1-12-97

HEALTH DEPT. COPY: WHITE INSPECTION COPY (FINAL): GREEN OWNER COPY (FINAL): YELLOW INSPECTION COPY (INITIAL): PINK OWNER COPY (INITIAL):