IREDELL COUNTY HEALTH DEPARTMENT

STATESVILLE 704-878-5305 MOORESVILLE 704-664-5281

IMPROVEMENT PERMIT / CERTIFICATE OF COMPLETION / OPERATION PERMIT / EXISTING SYSTEM INSPECTION

PROPERTY DESCRIPTION NO. 26357 DATE 4-8-97 TAX MAP NO. Pin 4870 87 8786 Watershed: ☐ Yes ☑ No

OWNER OR CONTRACTOR Harmon Properties PHONE: Business _____ Home _____

ADDRESS 5551 Monroe Rd Charlotte N.C. 28212

LOCATION Hwy 21 N TR Highland Ave TR Redmont TR Fisher Tree 7th lot left

SUBDIVISION Secrest BLOCK / SECTION _____ LOT 46 LOT AREA 1.045 acres SITE CLASS. PS DESIGN FLOW 360 L.T.A.R. .25

Septic Tank: 1000 Gallons; STB 1012 Date 6-24-97

Pump Tank: _____ Gallons; PT _____ Date _____

Pump Make: _____ Model _____ Serial No. _____

Nitrification Field: No Fields 1 Square Feet 1440 Linear Feet 480

No Lines 4 Trench Width 36" Max Trench Bottom Depth 24" Gravel Depth 12"

☐ New System ☐ Repair System Type: I, II, III, IV, V, VI

System Description: Conv. Gravity

Repair System Description Gravity Chambers

Maintenance Agreement Required: ☐ Yes ☐ No

☐ Slab ☑ Crawl Space ☐ Basement w/plumbing ☐ Basement wo/plumbing

☐ House/Mod. Home No. Bedrooms 3

☑ Mobile Home No. Bathrooms 2

☐ Business No. Employees _____


☐ Other _____

Water Supply: ☐ Individual ☐ Community ☑ Public


Comments:

Comments:

INITIAL SITE SKETCH

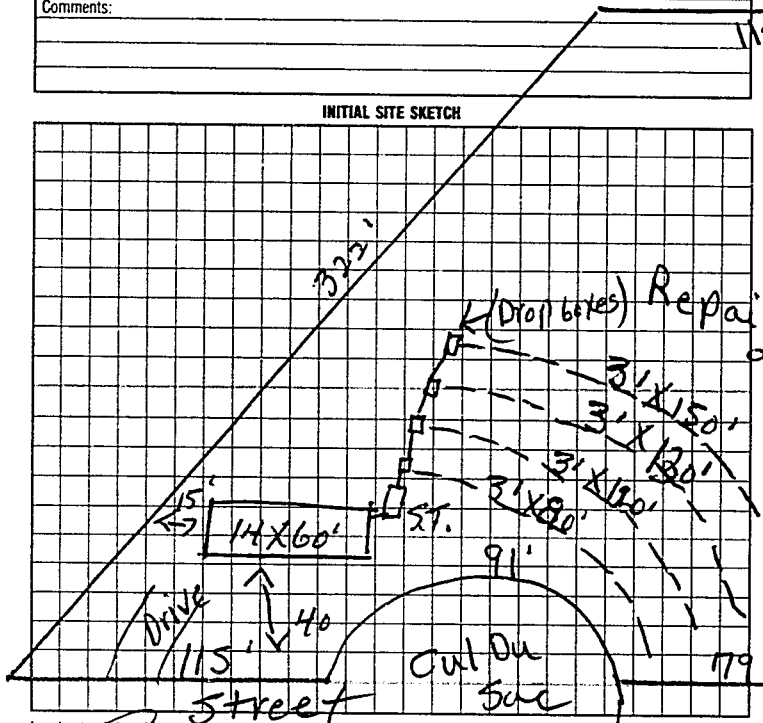

AS BUILT SKETCH

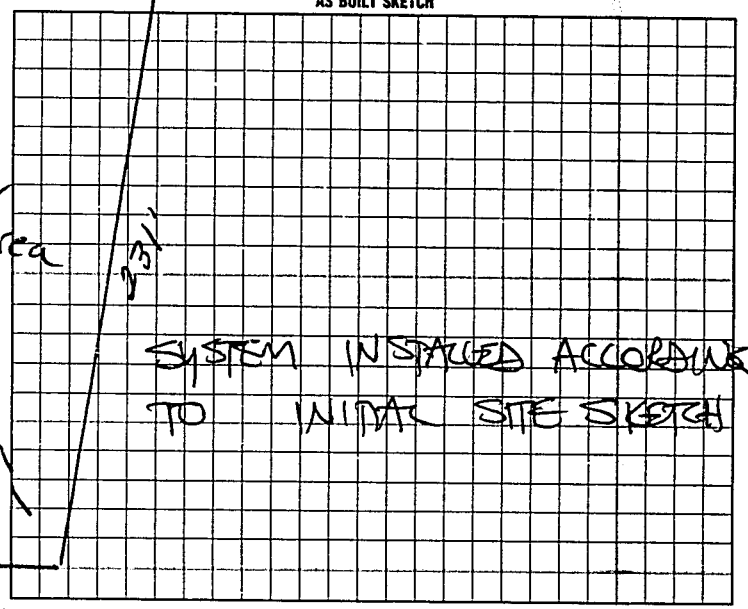

I understand that this permit can be suspended or revoked if any false information is supplied toward securing the permit/any unauthorized changes are made to the site/any unauthorized changes are made in the installation of the system.

Signed: Connie J Barkley

Improvement Permit by: R.C. Moore date 4-8-97

Authorization to Construct R.C. Moore date 4-8-97

Installed by: A-1 Backhoe

Certificate of Completion by: _____ date _____

Operation Permit by Steve Hendrick date 6.20.97

HEALTH DEPT. COPY: WHITE INSPECTION COPY (FINAL): GREEN OWNER COPY (FINAL): YELLOW INSPECTION COPY (INITIAL): PINK OWNER COPY (INITIAL): GOLD

Authorization to Construct Expires 6 months from Issue

0260000