IREDELL COUNTY HEALTH DEPARTMENT

Statesville Office (704) 878-5305 Mooresville Office (704) 660-3625 PERMIT # 180893

IMPROVEMENT PERMIT / AUTHORIZATION TO CONSTRUCT / OPERATION PERMIT / EXISTING SYSTEM

PIN # 4870878786

APPLICANT: Clayton Homes APPLICANT ADDRESS: 2026 Northside Dr

SITE ADDRESS: 151 Peppertree Dr. PHONE: 704-239-3693 ALT. PHONE: N/A

SITE DIRECTIONS: Hwy 21 N TR Highland Ave TR Redmond TR Peppertree Dr.

SUBDIVISION: Sagefield SECTION: N/A LOT # 46 LOT AREA: 1.105 acres DESIGN FLOW: 360 gpd L.T.A.R.: 0.25

Septic Tank Existing (gal) STB Date

Pump Tank (gal) PT Date

Pump Make Model Serial #

Nitrification Fields 1 # Lines 1 Linear Ft: 124'

Trench Width 36" Max. Trench Bottom Depth 27" Gravel Depth N/A

☐ New System ☐ Repair ☐ Expansion System Type: I II ☒ III IV V VI

System Description: 25% Reduction

Repair System Description: 25% Reduction (Shallow)

Maintenance Agreement Required: ☐ YES ☒ NO

☒ GRAVITY ☐ PRESSURE

☒ Residence ☐ Business ☐ Other ☐ Slab ☐ Basement w/plumbing


No. Bedrooms 3 No. Persons No. Employees ☒ Crawl Space

Water Supply: ☐ Private ☐ Public ☒ Community


☐ Basement w/o plumbing

Comments / Conditions: Install 124' of 25% Reduction on Contour with serial distribution. Install new nitrification line with trench bottom a 27" on high side. Cut-off first two existing lines 5' from out-building as shown below. Cut-off bottom existing line 5' from out-building & set new drop box as shown below

INITIAL SITE SKETCH

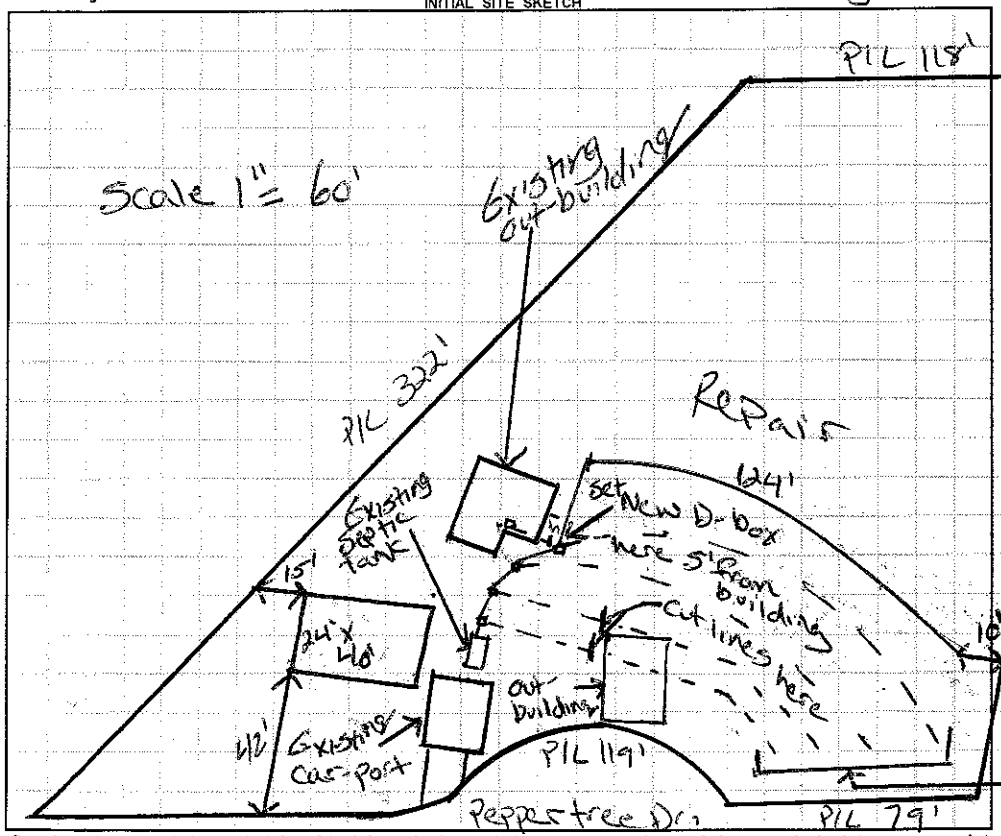

AS BUILT SKETCH

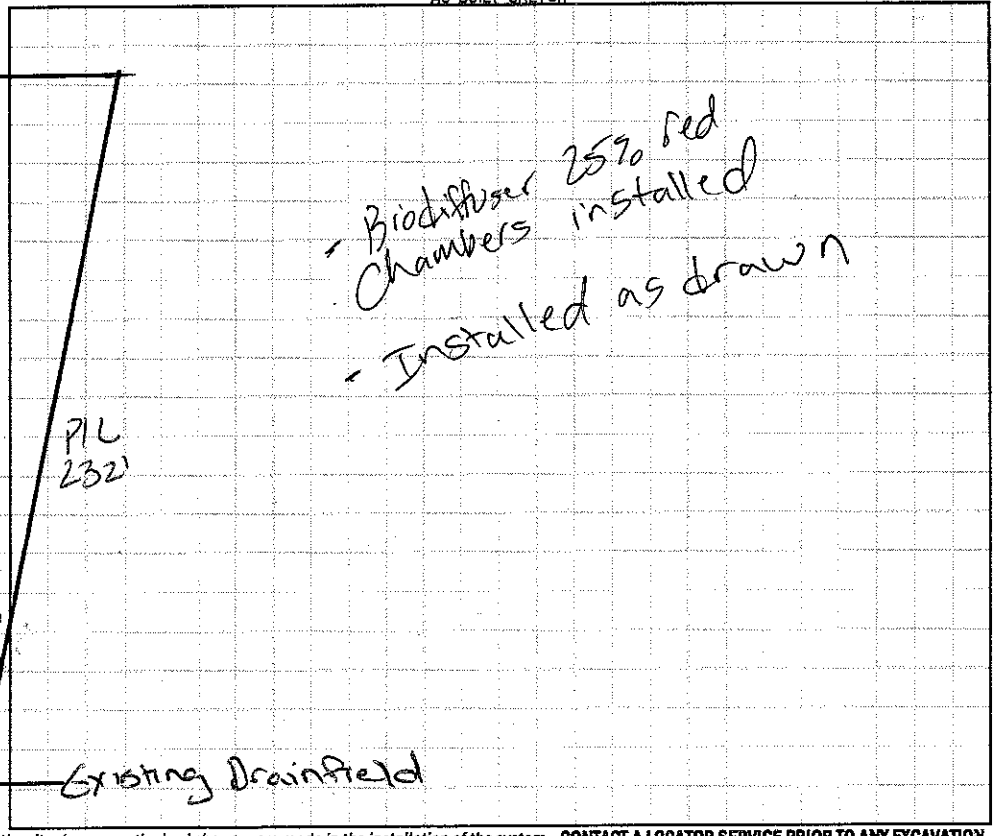

Permit can be suspended or revoked if any false information is supplied toward securing the permit / any unauthorized changes are made to the site / any unauthorized changes are made in the installation of the system. **CONTACT A LOCATOR SERVICE PRIOR TO ANY EXCAVATION**

☐ **IMPROVEMENT PERMIT** *with plat valid without expiration* ☒ **IMPROVEMENT PERMIT** *with site plan valid for 60 mos.* ☒ **AUTHORIZATION TO CONSTRUCT** *valid for period equal to IMPROVEMENT PERMIT--not to exceed 60 mo.*

Owner / Applicant Signature: Deena Abee Date: 10/8/13 Installed by: Tim Abee

IMPROVEMENT PERMIT by: Justin Henderson Date: 10-7-13 OPERATION PERMIT by: Justin Henderson Date: 10-11-13

AUTHORIZATION TO CONSTRUCT by: Justin Henderson Date: 10-7-13 Existing System Inspected by: Date:

Health Dept. Copy - WHITE Applicant (Final Approval) - YELLOW Applicant (Conditional Approval) - PINK