IREDELL COUNTY HEALTH DEPARTMENT

STATESVILLE 704-878-5305 MOORESVILLE 704-664-5281

IMPROVEMENT PERMIT / CERTIFICATE OF COMPLETION / OPERATION PERMIT / EXISTING SYSTEM INSPECTION

PROPERTY DESCRIPTION NO. 26358 DATE 4-8-97 ~~TAX MAP NO.~~ Pin No. 4870 88 0417 Watershed: ☑ Yes ☐ No

OWNER OR CONTRACTOR Harmony Properties PHONE: Business 532 6529 Home

ADDRESS 5551 Charlotte Hwy 28212

LOCATION Hwy 21 N TR Highland TR Belmont TR Pepper Tree TR Nettlebrook Fifton Rd

SUBDIVISION Sagefield BLOCK / SECTION LOT 13 LOT AREA 1.75 acres SITE CLASS PS DESIGN FLOW 360 L.T.A.R. .3

Septic Tank: 1050 Gallons; STB 1012 Date 2-19-97

Pump Tank: Gallons; PT Date

Pump Make: Model Serial No.

Nitrification Field: No Fields Square Feet Linear Feet

No Lines Trench Width Max Trench Bottom Depth Gravel Depth

☑ New System ☐ Repair System Type: I, II, III, IV, V, VI

System Description: Con Gravity

Repair System Description: Gravity Panels

Maintenance Agreement Required: ☐ Yes ☐ No

☐ Slab ☑ Crawl Space ☐ Basement w/plumbing ☐ Basement wo/plumbing

☐ House/Mod. Home No. Bedrooms 3

☑ Mobile Home No. Bathrooms 2

☐ Business No. Employees

☐ Other


Water Supply: ☐ Individual ☐ Community ☑ Public

Comments:


Comments:

* Note hit Rock 1/2 first line + ground Tank line keeping contour; shifted from initial sketch

INITIAL SITE SKETCH

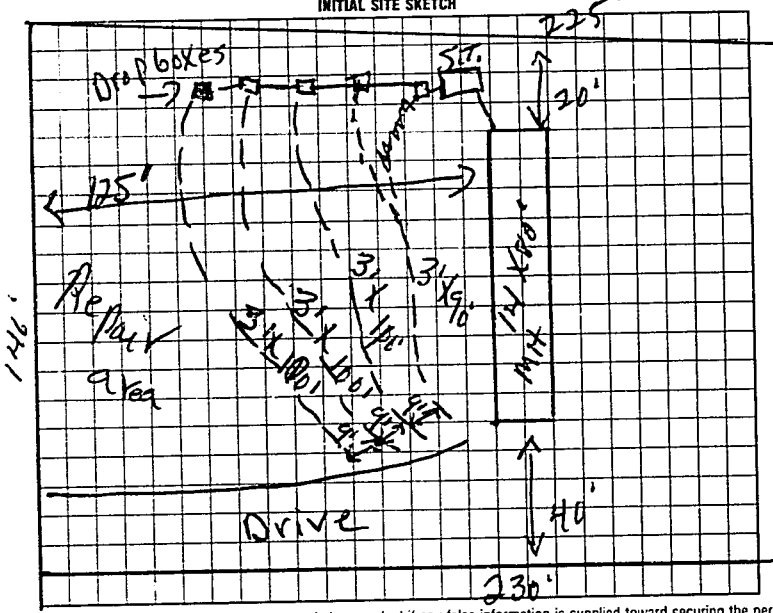

AS BUILT SKETCH

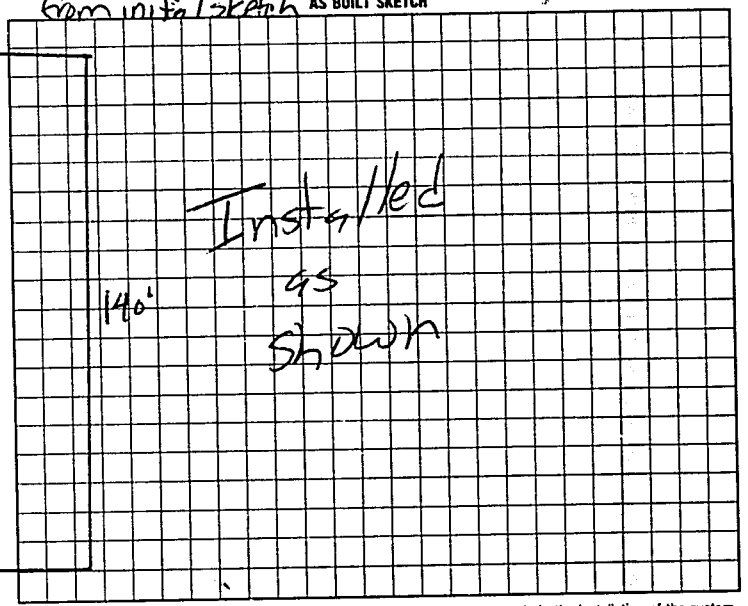

I understand that this permit can be suspended or revoked if any false information is supplied toward securing the permit/any unauthorized changes are made to the site/any unauthorized changes are made in the installation of the system.

Signed: Eileen McCarpa

Improvement Permit by: Authorization to court E. C. Moore date 4-8-97

Existing System Inspection by: E. C. Moore date 4-8-97

Installed by: Kenny Madison

Certificate of Completion by: date

Operation Permit by: Mark C. Oates date 4-18-97

HEALTH DEPT COPY: WHITE INSPECTION COPY (FINAL): GREEN OWNER COPY (FINAL): YELLOW INSPECTION COPY (INITIAL): PINK OWNER COPY (INITIAL): GOLD

to court. Authorization to court. Expires 60 mos from issue

9L6000