IREDELL COUNTY HEALTH DEPARTMENT

STATESVILLE 704-878-5305 MOORESVILLE 704-664-5281

IMPROVEMENT PERMIT / AUTHORIZATION TO CONSTRUCT / OPERATION PERMIT / EXISTING SYSTEM INSPECTION

PERMIT # 1516 3M PIN # 4870-88-0761 DATE

OWNER or APPLICANT Clayton Homes Melony Pack PHONE: Business Home:

OWNER or APPLICANT ADDRESS 5026 Nathan Dr Statesville NC 28677

LOCATION / DIRECTIONS 21 N Highland Point Ave R Redmon 5th lot on right

SUBDIVISION Sagefield BLOCK / SECTION I LOT # 8 LOT AREA .754 DESIGN FLOW 360 L.T.A.R. .3 (CV 87

Septic Tank 1000 (1250) Gallons: STB 821 Date 5-21-98

Pump Tank Gallons: P T Date

Pump Make Model Serial #

Nitrification Field No Fields 1 No Lines 5 Linear Feet 480

Trench Width 36" Max. Trench Bottom Depth 32" (34) Gravel Depth 12"

☑ New System ☐ Repair ☐ Expansion System Type I II III IV V VI

System Description: Conventional Gravity

Repair System Description: 2520 Gravity

Maintenance Agreement Required ☐ YES ☐ NO

☐ GRAVITY ☐ PRESSURE

☑ Residence No. Bedrooms 3

☐ Business No. Persons

☐ Other No. Employees

☐ Slab ☑ Crawl Space


☐ Basement w/plumbing ☐ Basement w/o plumbing

Water Supply: ☐ Private ☑ Public ☐ Community


Comments / Conditions

Comments / Conditions

INITIAL SITE SKETCH

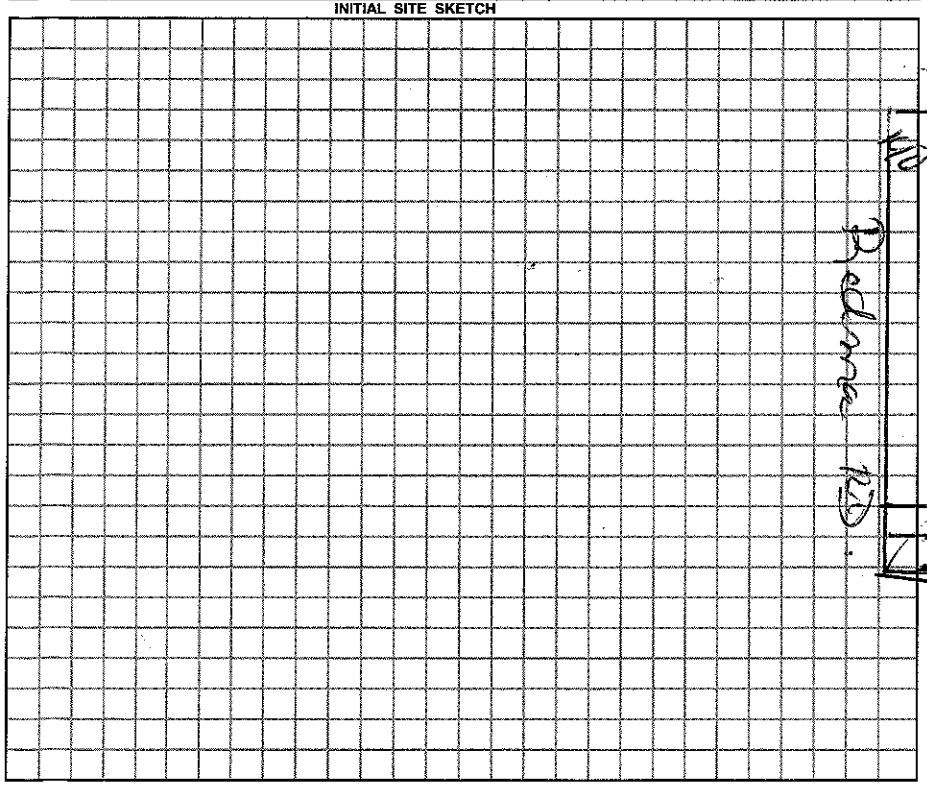

AS BUILT SKETCH

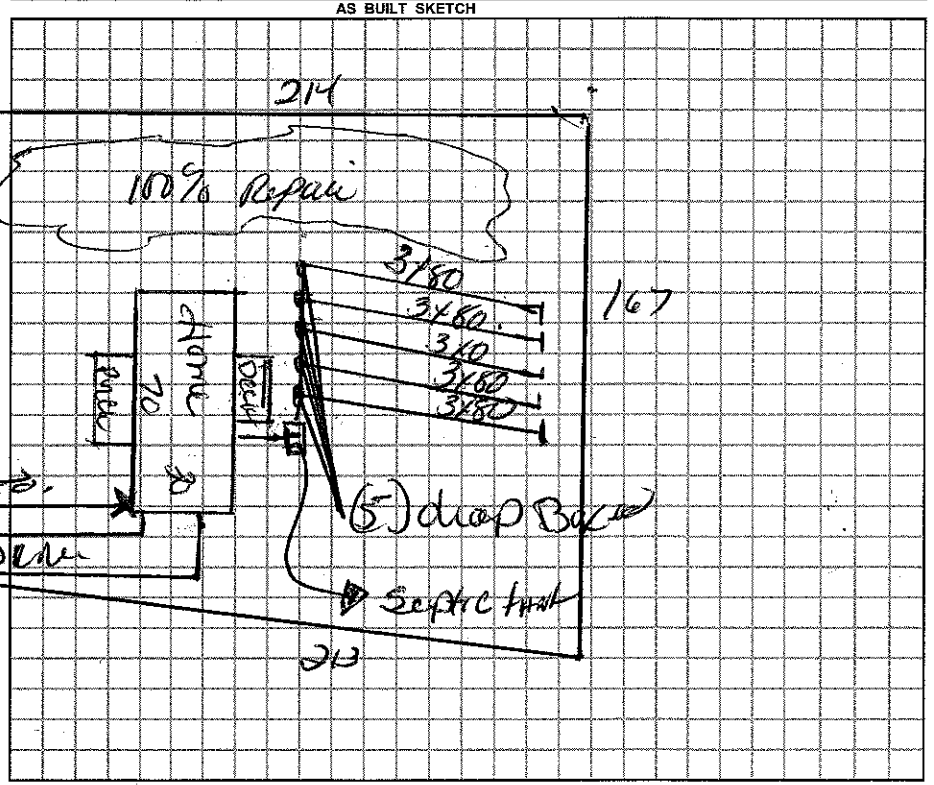

Permit can be suspended or revoked if any false information is supplied toward securing the permit / any unauthorized changes are made to the site / any unauthorized changes are made in the installation of the system.

☐ *IMPROVEMENT PERMIT w / plat valid without expiration.* ☐ *IMPROVEMENT PERMIT w / site plan valid for 60 mos.* ☑ *AUTHORIZATION TO CONSTRUCT valid for period equal to IMPROVEMENT PERMIT-not to exceed 60 mo.*

Owner / Applicant Signature: Date 5/26/09

Improvement Permit by: Date

Authorization to Construct by: Date

Installed by:

Operation Permit by: Date:

Existing System Inspected by: Date: 5-7-09

YOU SHOULD CONTACT A LOCATOR SERVICE PRIOR TO ANY EXCAVATION.

WHITE COPY Environmental Health YELLOW COPY (Final) Owner / Applicant PINK COPY (Initial) Owner / Applicant