IREDELL COUNTY HEALTH DEPARTMENT

STATESVILLE 704-878-5305 MOORESVILLE 704-664-5281

IMPROVEMENT PERMIT / CERTIFICATE OF COMPLETION / OPERATION PERMIT / EXISTING SYSTEM INSPECTION

PROPERTY DESCRIPTION NO. 68431 DATE 7-29-97 TAX MAP NO. 4870 88 1145 Watershed: ☑ Yes ☐ No

OWNER OR CONTRACTOR Harmony Properties PHONE: Business 704 532 6527 Home ~~704 532 6527~~ WSIB&W(1)

ADDRESS 5551 monroe Rd Charlotte N.C.

LOCATION 21N TR Highland Ave TR Redmont TR Pepper TR Nettlebrook 2nd 1st Rt

SUBDIVISION Sagefield BLOCK/SECTION II LOT 12 LOT AREA 1.75acres SITE CLASS PS DESIGN FLOW 360 L.T.A.R. 13

Septic Tank: 1000 Gallons; STB 1007 Date 8-18-97

Pump Tank: _____ Gallons; PT _____ Date _____

Pump Make: _____ Model _____ Serial No. _____

Nitrification Field: No Fields 1 Square Feet 1200 Linear Feet 400

No Lines 4 Trench Width 36" Max Trench Bottom Depth 36" Gravel Depth 12"

☐ New System ☐ Repair System Type: I, II, III, IV, V, VI

System Description: Conv. Gravity

Repair System Description: Gravity Chambers

Maintenance Agreement Required: ☐ Yes ☑ No

☐ House/Mod. Home ☑ Mobile Home ☐ Business ☐ Other

No. Bedrooms 3 No. Bathrooms 2 No. Employees ____


☐ Slab ☐ Crawl Space ☐ Basement w/plumbing ☐ Basement wo/plumbing

Water Supply: ☐ Individual ☐ Community ☑ Public


Comments:

Comments:

INITIAL SITE SKETCH 230'

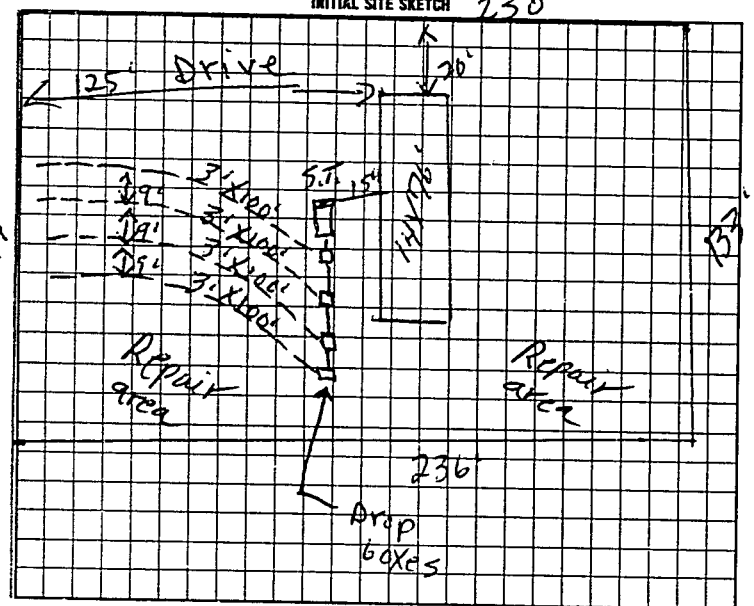

AS BUILT SKETCH

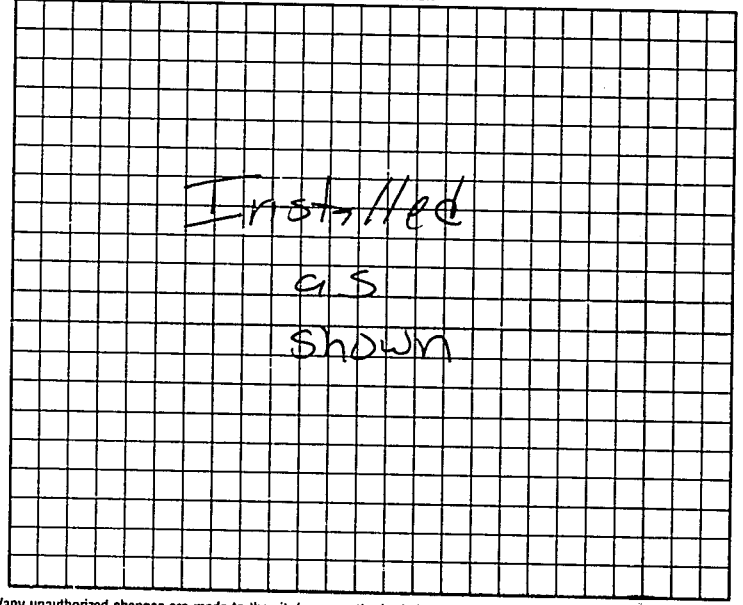

I understand that this permit can be suspended or revoked if any false information is supplied toward securing the permit/any unauthorized changes are made to the site/any unauthorized changes are made in the installation of the system. Improvement Permit is valid for 60 months from date of issuance.

Signed: X James T. Barkley

Improvement Permit by: P.C. Moore date 7-29-97

Existing System Approved by: P.C. Moore date 7-29-97

Authorization to Const.

Installed by: James Huddler

Certificate of Completion by: _____ date _____

Operation Permit by: M J C Ortiz date 10-1-97

HEALTH DEPT COPY WHITE INSPECTION COPY (FINAL) GREEN OWNER COPY (FINAL) YELLOW INSPECTION COPY (INITIAL) PINK OWNER COPY (INITIAL) GOLD

Authorization to Const Expires 60 mos from issue

0 5 6 0 0 0