# IREDELL COUNTY HEALTH DEPARTMENT

STATESVILLE 704-878-5305 MOORESVILLE 704-664-5281

## IMPROVEMENT PERMIT / CERTIFICATE OF COMPLETION / OPERATION PERMIT / EXISTING SYSTEM INSPECTION

PROPERTY DESCRIPTION NO. 070451 DATE 11-26-97 TAX MAP NO. 4870 88 2210 Watershed: ☐ Yes ☒ No

OWNER OR CONTRACTOR HARMONY PROPERTIES, INC PHONE: Business Home 532-6527

ADDRESS 5551 MONROE ROAD, CHARLOTTE, NC 28212

LOCATION US 21 N, TR TOMLINSON AVE, TR REDMON RD, TR PEPPERTREE DR, TR NETTLEBROOK LANE, 2ND LOT ON LEFT

SUBDIVISION SAGEFIELD BLOCK / SECTION II LOT 21 LOT AREA 0.746 ACRE SITE CLASS. PS1 DESIGN FLOW 360 L.T.A.R. 0.30 GPD/FT²

Septic Tank: 1000 Gallons; STB 821 Date 11-11-97

Pump Tank: Gallons; PT Date

Pump Make: Model Serial No.

Nitrification Field: No Fields 1 Square Feet 1200 Linear Feet 400

No Lines FOUR Trench Width 36" Max Trench Bottom Depth 30" Gravel Depth 12"

☒ New System ☐ Repair System Type: I, II, III, IV, V, VI

System Description: CONVENTIONAL GRAVITY

Repair System Description: CONV. GRAVITY

Maintenance Agreement Required: ☐ Yes ☒ No

☐ House/Mod. Home ☒ Mobile Home ☐ Business ☐ Other

No. Bedrooms 3 No. Bathrooms 2 No. Employees


☐ Slab ☒ Crawl Space ☐ Basement w/plumbing ☐ Basement wo/plumbing

Water Supply: ☐ Individual ☐ Community ☒ Public


Comments: NO CUTTING OR FILLING OF SOIL ALLOWED OVER SEPTIC DRAINFIELD - INSTALL LINES NO DEEPER THAN 30"

Comments:

INITIAL SITE SKETCH SCALE: 1"=40'

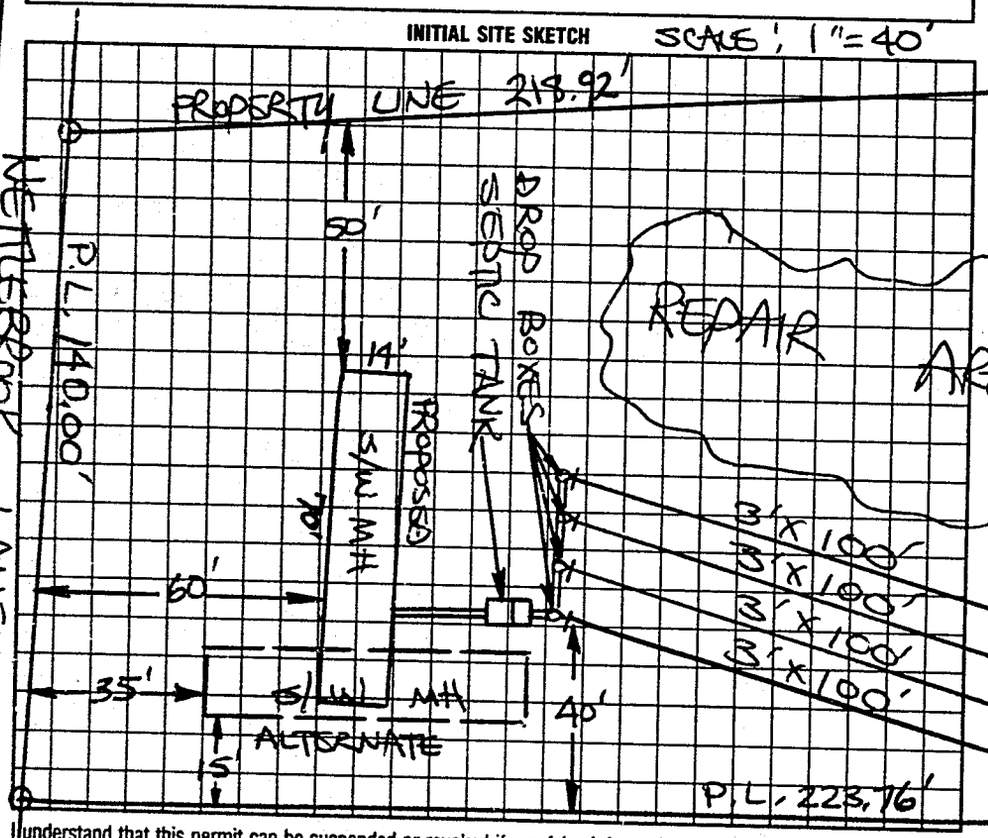


AS BUILT SKETCH

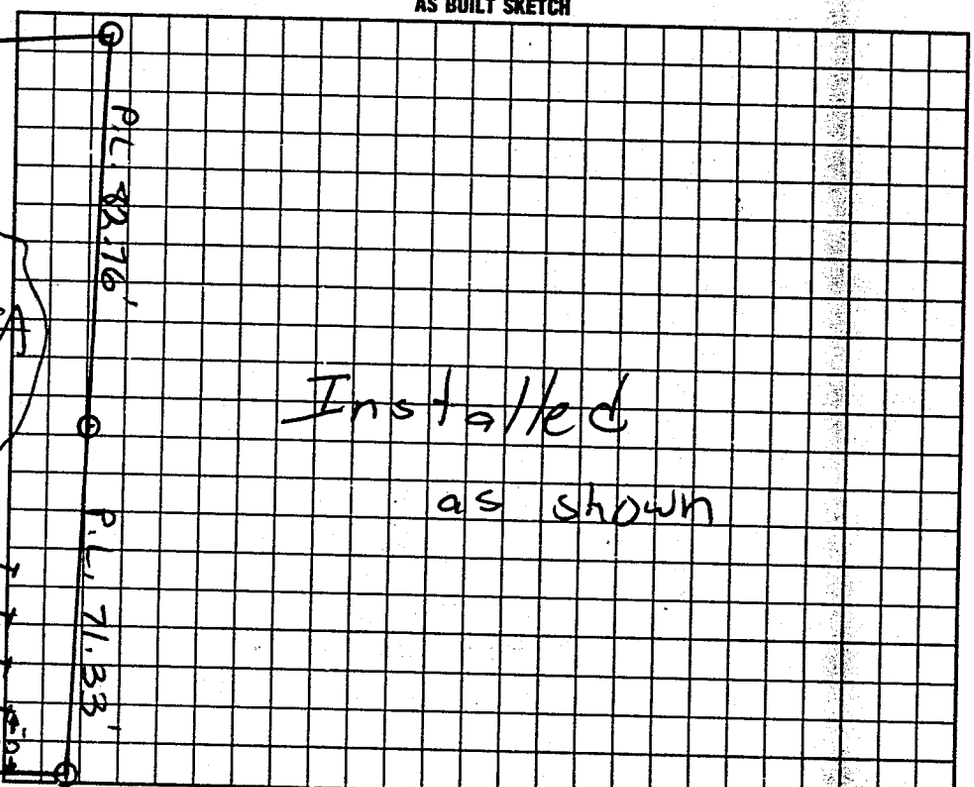


I understand that this permit can be suspended or revoked if any false information is supplied toward securing the permit/any unauthorized changes are made to the site/any unauthorized changes are made in the installation of the system. Improvement Permit is valid for 60 months from date of issuance. AUTHORIZATION TO CONSTRUCT IS VALID FOR 60 MONTHS FROM DATE OF ISSUANCE.

Signed:

Improvement Permit by: STEVE HENDRICK date 11-26-97

AUTH. TO CONST.

Existing System Inspection by: STEVE HENDRICK date 11-26-97

Installed by: G+M Enterprise

~~Certificate of Completion~~ by: date

Operation Permit by: Mark C. Ott RS date 11-98

HEALTH DEPT. COPY: WHITE INSPECTION COPY (FINAL): GREEN OWNER COPY (FINAL): YELLOW INSPECTION COPY (INITIAL): PINK OWNER COPY (INITIAL): GOLD