IREDELL COUNTY HEALTH DEPARTMENT

STATESVILLE 704-878-5305 MOORESVILLE 704-664-5281

IMPROVEMENT PERMIT / CERTIFICATE OF COMPLETION / OPERATION PERMIT / EXISTING SYSTEM INSPECTION

PROPERTY DESCRIPTION NO. 68429 DATE 7-29-97 TAX MAP NO. 4870 88 4149 Watershed: ☑ Yes ☐ No WSIII B;W

OWNER OR CONTRACTOR Harmony Properties PHONE: Business 704 532 6529 Home

ADDRESS 5551 Monroe Rd Charlotte N.C.

LOCATION 21N TR Highland TR Redmond TR Peepper TR Nettlebrook on corner

SUBDIVISION Sagefield BLOCK / SECTION II LOT 22 LOT AREA 1.22 SITE CLASS. PS DESIGN FLOW 360 L.T.A.R. 1.3

Septic Tank: 1000 Gallons; STB 821 Date 2-2-98

Pump Tank: Gallons; PT Date

Pump Make: Model Serial No.

Nitrification Field: No Fields 1 Square Feet 1200 Linear Feet 400

No Lines 3 Trench Width 36" Max Trench Bottom Depth 36" Gravel Depth 12"

☐ New System ☐ Repair System Type: I, ☑ II, III, IV, V, VI

System Description: Conv. Gravity

Repair System Description: " "

Maintenance Agreement Required: ☐ Yes ☑ No

☐ House/Mod. Home ☑ Mobile Home ☐ Business ☐ Other

No. Bedrooms 3 No. Bathrooms 2 No. Employees


☐ Slab ☐ Crawl Space ☐ Basement w/plumbing ☐ Basement wo/plumbing

Water Supply: ☐ Individual ☐ Community ☑ Public

Comments:

Comments:

INITIAL SITE SKETCH

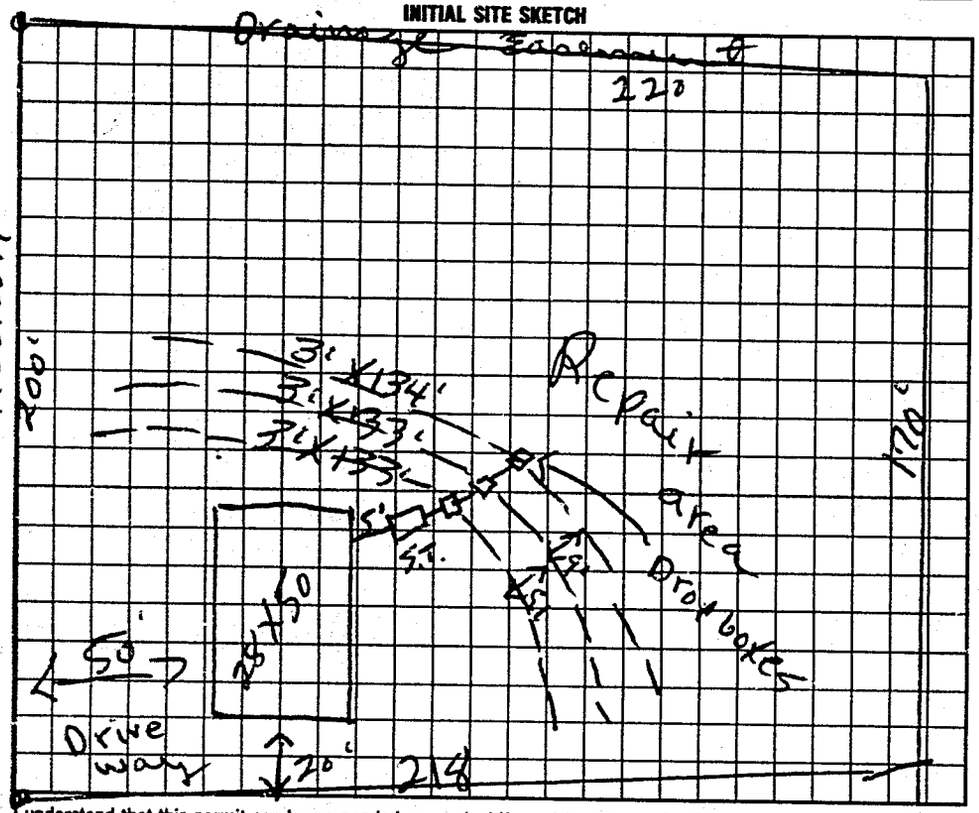

AS BUILT SKETCH

Installed as shown

I understand that this permit can be suspended or revoked if any false information is supplied toward securing the permit/any unauthorized changes are made to the site/any unauthorized changes are made in the installation of the system. Improvement Permit is valid for 60 months from date of issuance.

Signed: James J. Barkley

Improvement Permit by: P.C. moore date 7-29-97

Existing System Inspection by: P.C. moore date 7-29-97

Authorization to Court

Installed by: O+M Enterprises

Certificate of Completion by: date

Operation Permit by: Mark Collins date 3-11-98

HEALTH DEPT COPY: WHITE INSPECTION COPY (FINAL): GREEN OWNER COPY (FINAL): YELLOW INSPECTION COPY (INITIAL): PINK OWNER COPY (INITIAL): GOLD

Authorization to Court Expires 60 mos From issue