IREDELL COUNTY HEALTH DEPARTMENT

STATESVILLE 704-878-5305 MOORESVILLE 704-664-5281

IMPROVEMENT PERMIT / AUTHORIZATION TO CONSTRUCT / OPERATION PERMIT / EXISTING SYSTEM INSPECTION

PERMIT# 079473 PIN# 4870 88 3669 DATE 3-11-99

OWNER OR CONTRACTOR HARMONY PROPERTIES PHONE: Business 532-6625 Home

ADDRESS 5551 MONROE ROAD, CHARLOTTE, NC 28212

LOCATION US 21 N, TR HIGHLAND POINT, TR REDMON ROAD, TR PEPPERTREE, 1ST LOT ON RIGHT

SUBDIVISION SAGEFIELD BLOCK / SECTION II LOT 10 LOT AREA 0.745 ACRES SITE CLASS PS DESIGN FLOW 360 L.T.A.R. 0.30 GAD/FT2

Septic Tank: 1000 Gallons; STB 786 Date 1-15-99
Pump Tank: Gallons; PT Date
Pump Make: Model Serial No
Nitrification Field: No. Fields 1 Square Feet 1200 Linear Feet 400
No. Lines FOUR Trench Width 36" Max Trench Bottom Depth 28"

✓ New System Repair System Type: I (II) III IV V VI
System Description: CONVENTIONAL GRAVITY
Repair System Description: LOW PRESSURE PIPE
Maintenance Agreement Required: Yes ✓ No
Gravel Depth 12" Slab ✓ Crawl Space Basement w/plumbing Basement wo/plumbing


✓ House/Mod. Home No. Bedrooms 3
✓ Mobile Home No. Bathrooms 2
Business No. Employees
Other

Water Supply: ☐ Individual ☐ Public ☐ Community

Comments/Conditions: USE THREE EZOD BOXES FOR SERIAL DISTRIBUTION


Comments Conditions

INITIAL SITE SKETCH

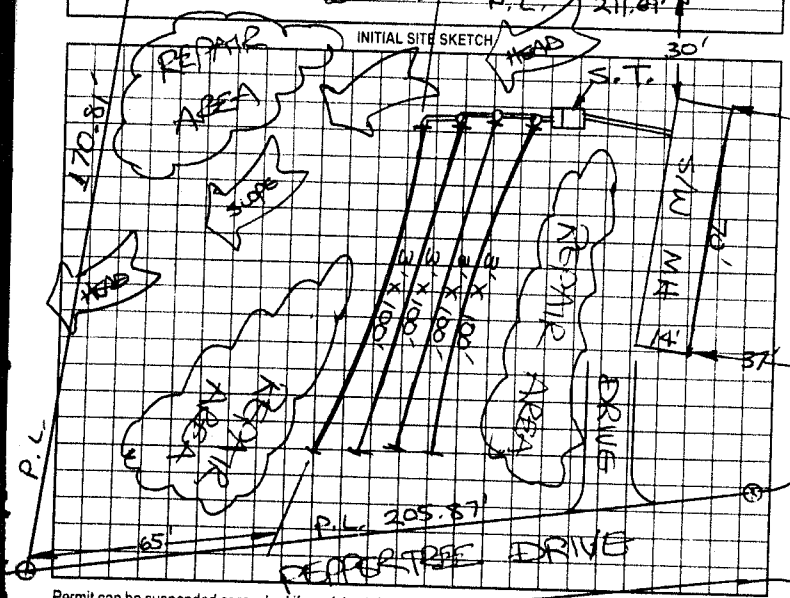

SCALE: 1"=40'

AS BUILT SKETCH

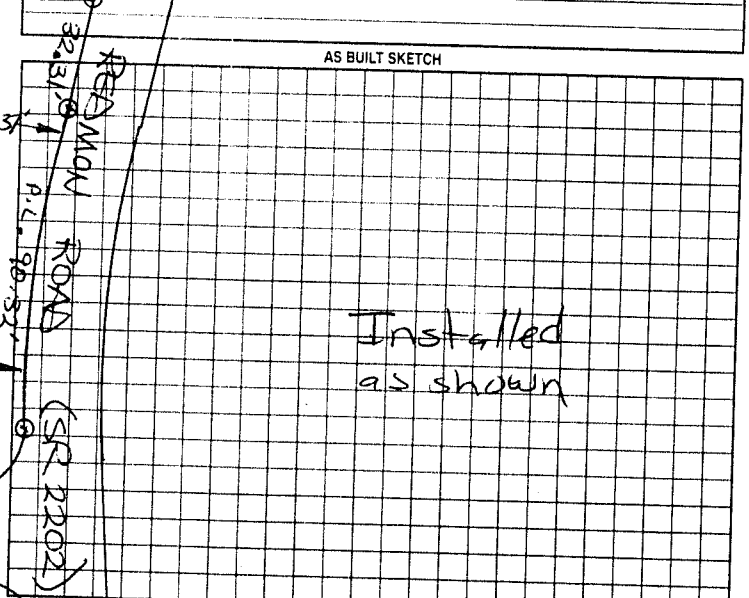

Permit can be suspended or revoked if any false information is supplied toward securing the permit/any unauthorized changes are made to the site/any unauthorized changes are made in the installation of the system. Improvement Permit with plat valid without expiration. Improvement Permit with site plan valid for sixty months. Authorization to Construct is valid for a period equal to that of Improvement Permit – not to exceed sixty months.

Signed: Mark D. Trull date 3-11-99

Improvement Permit by: STEVE HEDRICK date 3-11-99

Authorization to Construct by: STEVE HEDRICK date 3-11-99

Installed by: G+M Enterprises

Operation Permit by: Allen C Ortis date 3-12-99

Existing System Inspection by: date

HEALTH DEPT COPY WHITE OWNER COPY (FINAL) YELLOW OWNER COPY (INITIAL) PINK