IREDELL COUNTY HEALTH DEPARTMENT

STATESVILLE 704-878-5305 MOORESVILLE 704-664-5281

IMPROVEMENT PERMIT / AUTHORIZATION TO CONSTRUCT / OPERATION PERMIT / EXISTING SYSTEM INSPECTION

PERMIT# 079617 PIN# 4870 88 5795 DATE 2-25-99

OWNER OR CONTRACTOR HARMONY PROPERTIES PHONE: Business 532-6527 Home

ADDRESS 5551 MONROE ROAD, CHARLOTTE NC 28212

LOCATION US 21 N, TR HIGHLAND POINT AVE, TR REDMON, TR PEARTREE, 1ST LOT ON LEFT

SUBDIVISION SAGEFIELD BLOCK / SECTION II LOT 52 LOT AREA 0.753 Acre SITE CLASS PS DESIGN FLOW 360 L.T.A.R. 0.30 GPD/FT²

Septic Tank: 1000 Gallons: STB 750 Date 12-28-98
Pump Tank: Gallons: PT Date
Pump Make: Model Serial No.
Nitrification Field: No Fields 1 Square Feet EQT 1200 Linear Feet 300+
No Lines FIVE Trench Width 36" Max Trench Bottom Depth 36" Gravel Depth 34"-36"

✓ New System Repair System Type: I II III IV V
System Description: 25% REDUCTION SYSTEM
Repair System Description: PIPES GRAVITY
Maintenance Agreement Required: Yes ✓ No
Slab ✓ Crawl Space Basement w/plumbing Basement wo/plumbing


House/Mod. Home No. Bedrooms 3
Mobile Home No. Bathrooms 2
Business No. Employees
Other

Water Supply: ☐ Individual ☑ Public ☐ Community


Comments/Conditions: INSTALL 25% REDUCTION SYSTEM USING FIFTY (50) CHAMBER OR THIRTY (30) H.D.S. SECTIONS.

Comments/Conditions

INITIAL SITE SKETCH

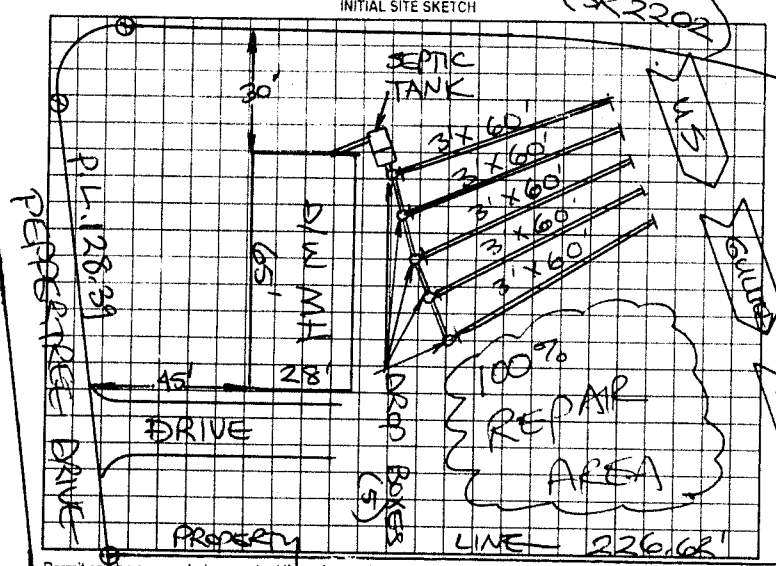

AS BUILT SKETCH

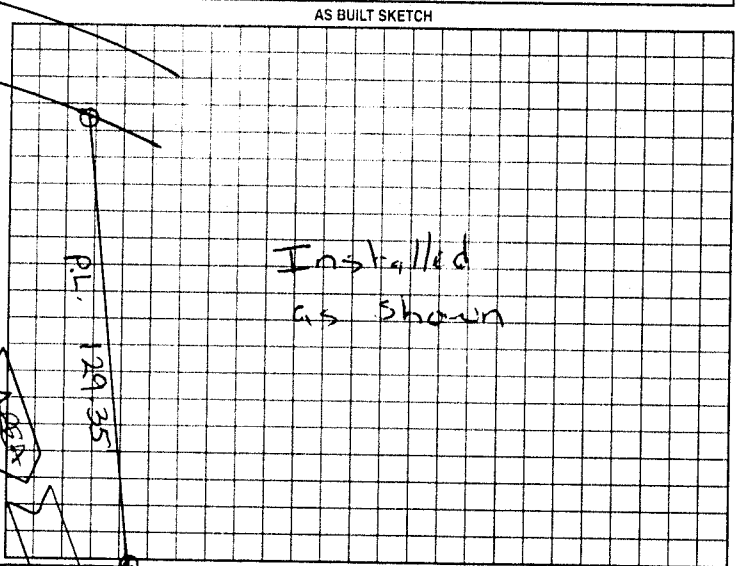

Permit can be suspended or revoked if any f... information is supplied toward securing the permit/any unauthorized changes are made to the site/any unauthorized changes are made in the installation of the system. Improvement Permit with plat valid without expiration. Impr...ent Permit with site plan valid for sixty months. Authorization to Construct is valid for a period equal to that of Improvement Permit – not to exceed sixty months.

Signed: [signature] date 3-3-99

Improvement Permit by: STEVE HEDRICK date 2-26-99

Authorization to Construct by: STEVE HEDRICK date 2-25-99

Installed by: G & M Enterprises

Operation Permit by: [illegible] County HS date 3-11-99

Existing System Inspection by: date

HEALTH DEPT COPY WHITE OWNER COPY (FINAL) YELLOW OWNER COPY (INITIAL) PINK