63678

IREDELL COUNTY HEALTH DEPARTMENT

STATESVILLE 704-878-5305 MOORESVILLE 704-664-5281

IMPROVEMENT PERMIT / CERTIFICATE OF COMPLETION / OPERATION PERMIT / EXISTING SYSTEM INSPECTION

PROPERTY DESCRIPTION NO. 25105 DATE 10-3-96 TAX MAP NO. 12N-7-A-48 Watershed: ☒ Yes ☐ No

OWNER OR CONTRACTOR Olde Town mobile Homes PHONE: Business 873-1481 Home Lowell Bow

ADDRESS 2016 Northside Dr Sta

LOCATION 21N To Harmony TR High Point Ave TR Redman TR Peppertime on L

SUBDIVISION Sagefield BLOCK / SECTION II LOT 48 LOT AREA 1.76 acres SITE CLASS. PS DESIGN FLOW ~~360~~ 240 L.T.A.R. .28

Septic Tank: ____ Gallons; STB 794 Date 8-6-96

Pump Tank: ____ Gallons; PT ____ Date ____

Pump Make: ____ Model 857 Serial No. 385

Nitrification Field: No Fields 1 Square Feet ~~1275~~ Linear Feet 425

No Lines 4 Trench Width 36" Max Trench Bottom Depth 30" Gravel Depth 12"

☒ New System ☐ Repair System Type: ☐ II ☐ III, IV, V, VI

System Description: Conv. Gravity

Repair System Description Gravity Chambers

Maintenance Agreement Required: ☐ Yes ☒ No

☐ House/Mod. Home No. Bedrooms ~~3~~ 2

☐ Mobile Home No. Bathrooms 2

☐ Business No. Employees ____

☐ Other ____


☐ Slab ☐ Crawl Space ☐ Basement w/plumbing ☐ Basement wo/plumbing

Water Supply: ☐ Individual ☐ Community ☒ Public

Comments:

Comments:

INITIAL SITE SKETCH

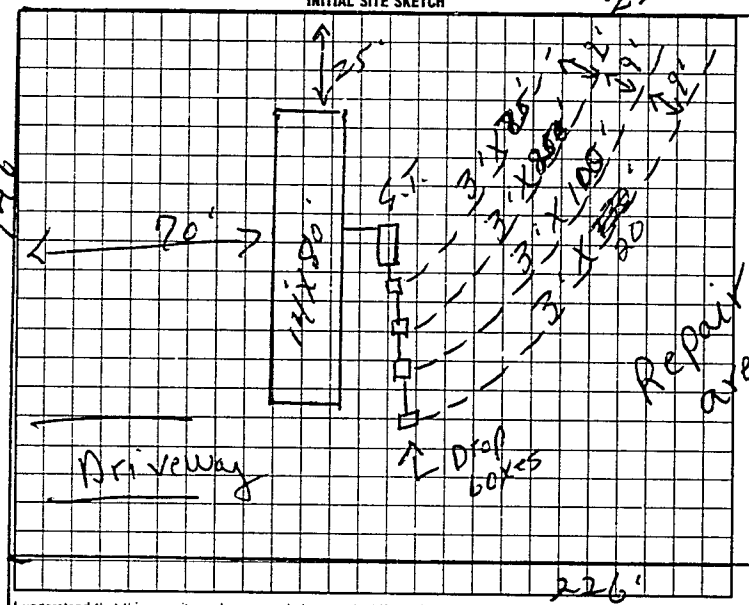

AS BUILT SKETCH

Installed as shown

I understand that this permit can be suspended or revoked if any false information is supplied toward securing the permit/any unauthorized changes are made to the site/any unauthorized changes are made in the installation of the system.

Signed: Eric W. Holl

Improvement Permit by: E.C. moore date 10-3-96

Existing System Inspection by: Authorized E.C. moore date 10-3-96

to commence

Installed by: A-1 Backhoe

Certificate of Completion by ____ date ____

Operation Permit by M. Cox RS date 10-16-96

INSPECTION COPY (FINAL) GREEN OWNER COPY (FINAL) YELLOW INSPECTION COPY (INITIAL) PINK OWNER COPY (INITIAL) GOLD

Authorization to Const. EXPIRES 60 mos from issue