IREDELL COUNTY HEALTH DEPARTMENT

STATESVILLE 704-878-5305 MOORESVILLE 704-664-5281

IMPROVEMENT PERMIT / AUTHORIZATION TO CONSTRUCT / OPERATION PERMIT / EXISTING SYSTEM INSPECTION

PERMIT# 095479 PIN# 4870 89 5765 DATE April 26, 01

OWNER OR CONTRACTOR Allen Hopkins PHONE: Business Home (704) 546-2325

ADDRESS 313 Butler Mill Road HARMONY NC 28634

LOCATION From Stowe 21 N thru Harmony TR Tomlinson (turns into Butler Mill Rd) ~¼ mile on left #313

SUBDIVISION BLOCK / SECTION LOT LOT AREA 1 Ac+ SITE CLASS PS DESIGN FLOW 360 gpd L T A.R. .3

Septic Tank: Existing* Gallons: STB Date

Pump Tank: Gallons: PT Date

Pump Make: Model Serial No

Nitrification Field: No Fields 1 Square Feet 1200 Linear Feet 400

No Lines 4 Trench Width 36" Max Trench Bottom Depth 36" Gravel Depth 12"

☑ New System ☐ Repair System Type: I II III IV V VI

System Description System Upgrade - GRAV CONVENTIONAL

Repair System Description: CONV / INNOV.

Maintenance Agreement Required: ☐ Yes ☑ No

☑ House/Mod. Home No. Bedrooms 3

☐ Mobile Home No. Bathrooms 1-2

☐ Business No. Employees

☐ Other


☐ Slab ☑ Crawl Space ☐ Basement w/plumbing ☐ Basement wo/plumbing

Water Supply: ☐ Individual ☑ Public ☐ Community


Comments/Conditions: *OK to use EXISTING septic tank if in good condition and of Adequate capacity. Will NEED Approx 90' of 3"-4" sch 40 from EXISTING tank to NEW drainfield area. DISCONNECT old LINE AT tank. Follow CONTOUR with LATERALS AS Flagged.

Comments/Conditions: NEW SANITARY TEE INSTALLED IN SEPTIC TANK

INITIAL SITE SKETCH

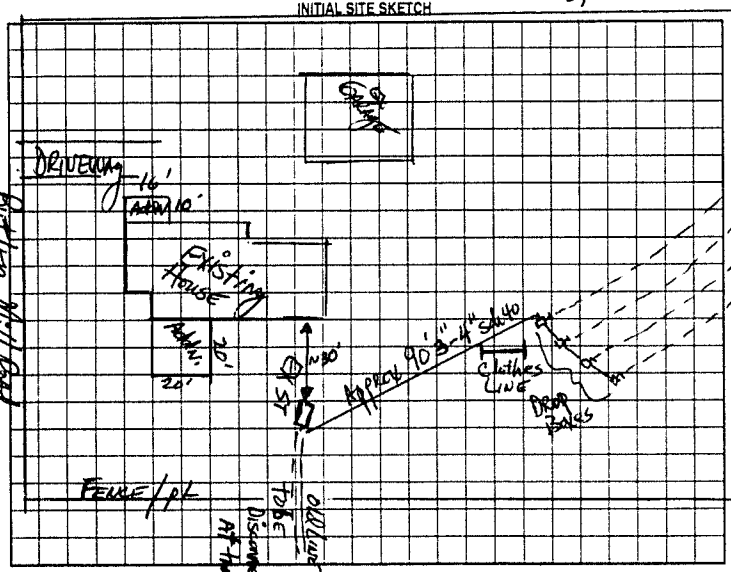

AS BUILT SKETCH

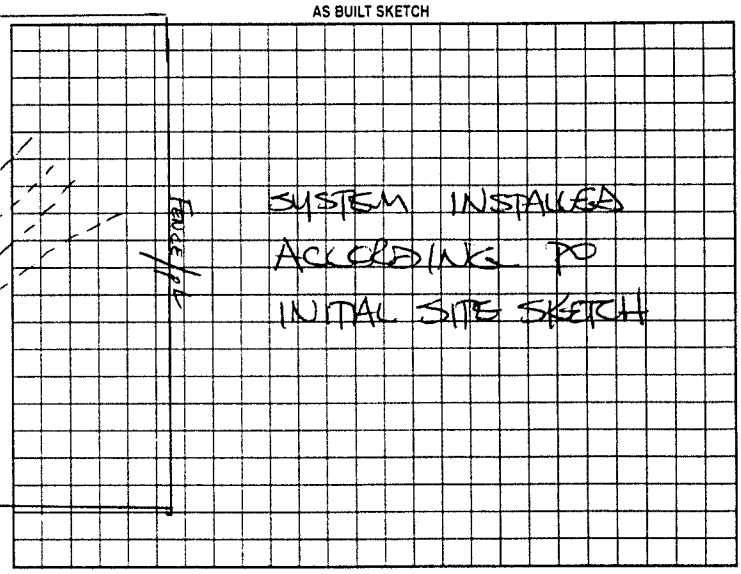

Permit can be suspended or revoked if any false information is supplied toward securing the permit/any unauthorized changes are made to the site/any unauthorized changes are made in the installation of the system. Improvement Permit with plat valid without expiration. Improvement Permit with site plan valid for sixty months. Authorization to Construct is valid for a period equal to that of Improvement Permit – not to exceed sixty months.

Signed: [signature] date 11-27-01 Installed by: SAMMY REAVIS

Improvement Permit by: [signature] date 4-26-01 Operation Permit by: STEVE HENRICK date 10-19-01

Authorization to Construct by: [signature] date 4-26-01 Existing System Inspection by: date

HEALTH DEPT COPY WHITE OWNER COPY (FINAL) YELLOW OWNER COPY (INITIAL) PINK