(C1)

IREDELL COUNTY HEALTH DEPARTMENT

STATESVILLE 704-878-5305 MOORESVILLE 704-664-5281

IMPROVEMENT PERMIT / AUTHORIZATION TO CONSTRUCT / OPERATION PERMIT / EXISTING SYSTEM INSPECTION

PERMIT# 140549 PIN# 4870982733 1776 DATE 3-16-07

OWNER OR APPLICANT Jas Redmon PHONE: Business _____ Home 704-546-7400

ADDRESS 185 Redmon

LOCATION Hwy 21 N, (R) on Tomlinson Rd (R) on Redmon

SUBDIVISION n/a BLOCK / SECTION _____ LOT _____ LOT AREA _____ SITE CLASS. RS DESIGN FLOW 360 L.T.A.R. .25

Septic Tank: 1000 Gallons; STB Short 960 Date 4-22-07

Pump Tank: _____ Gallons; PT _____ Date _____

Pump Make: _____ Model _____ Serial No. _____

Nitrification Field: No Fields 1 Square Feet 1440 Linear Feet 360

No Lines 3 Trench Width 36" Max Trench Bottom Depth 30" Gravel Depth n/a

☒ New System ☐ Repair ☐ Expansion System Type: I (II) III IV V VI

System Description: 25% Reduction

Repair System Description: 25% Reduction

Maintenance Agreement Required: ☐ Yes ☒ No

☒ Gravity ☐ Pressure

☒ House/Mod. Home No. Bedrooms 3

☐ Mobile Home No. Persons ____

☐ Business No. Employees ____

☐ Other _____


Water Supply: ☒ Individual ☐ Public ☐ Community

☐ Slab ☒ Crawl Space ☐ Basement w/plumbing ☐ Basement wo/plumbing


Comments/Conditions:

Comments/Conditions: Filter installed.

INITIAL SITE SKETCH

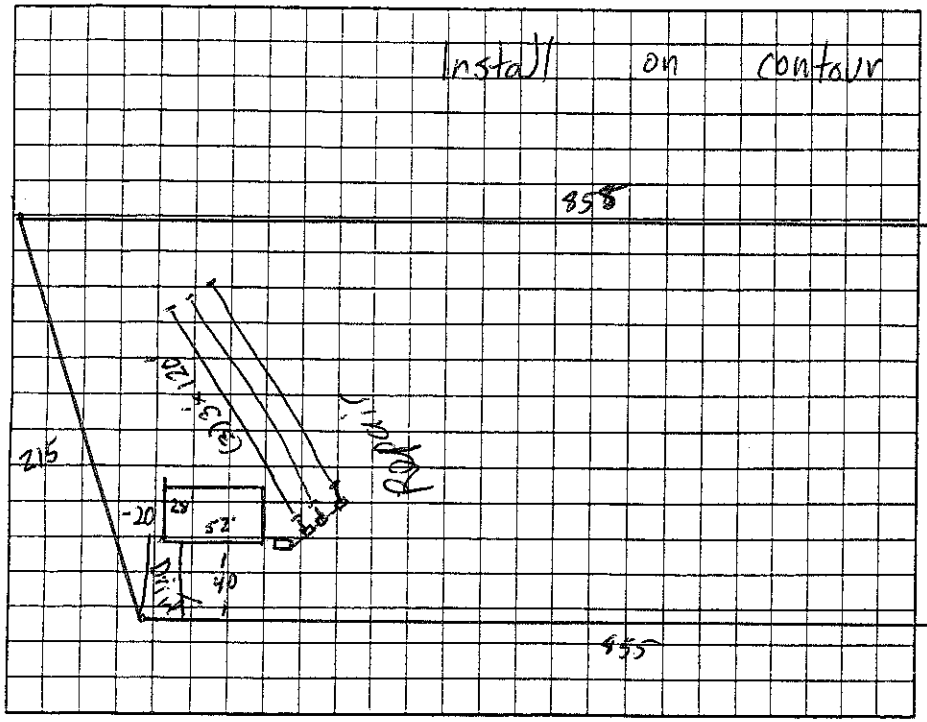

AS BUILT SKETCH

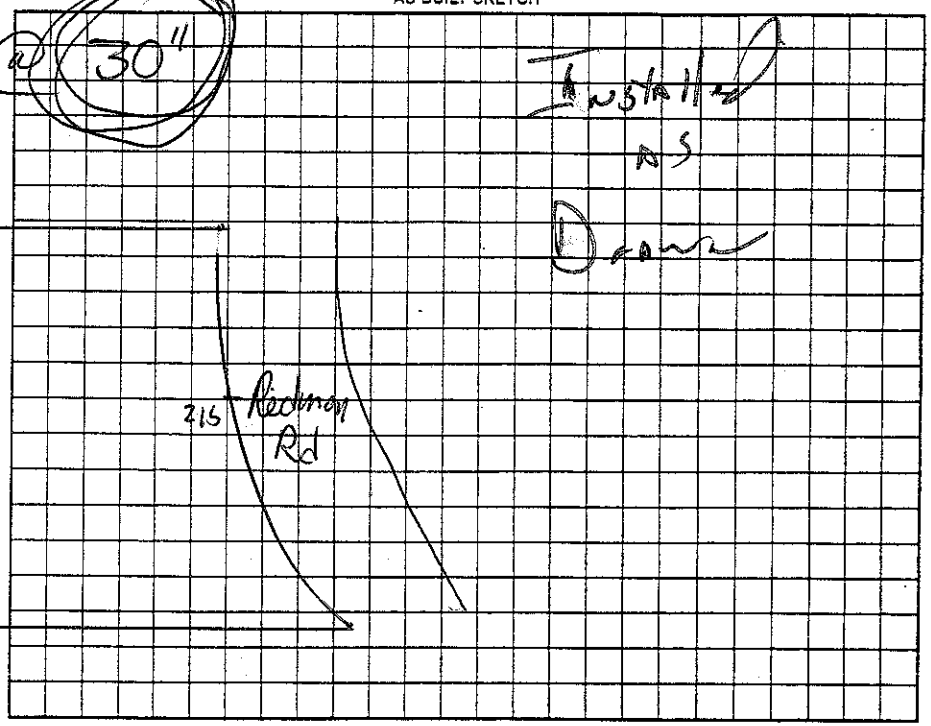

Permit can be suspended or revoked if any false information is supplied toward securing the permit/any unauthorized changes are made to the site/any unauthorized changes are made in the installation of the system. Improvement Permit with plat valid without expiration ☐ Improvement Permit with site plan valid for sixty months ☐ Authorization to Construct is valid for a period equal to that of Improvement Permit – not to exceed sixty months.

Signed: Annie B Redmon date 3-19-07

Improvement Permit by: _____ date 3-16-07

Authorization to Construct by: _____ date 3-16-07

Installed by: Samuel Reavis

Operation Permit by: _____, R.S. date 9 Aug 07

Existing System Inspection by: _____ date _____

HEALTH DEPT. COPY: WHITE OWNER COPY (FINAL): YELLOW OWNER COPY (INITIAL): PINK