THIS PERMIT VOIDS PREVIOUS ISSUED 10-6-99

IREDELL COUNTY HEALTH DEPARTMENT

STATESVILLE 704-878-5305 MOORESVILLE 704-664-5281

IMPROVEMENT PERMIT / AUTHORIZATION TO CONSTRUCT / OPERATION PERMIT / EXISTING SYSTEM INSPECTION

PERMIT# 083740 PIN# 4871 03 2325 DATE 11-3-99

OWNER OR CONTRACTOR IREDELL WELDING PHONE: Business 902-7048 Home 546-3121

ADDRESS P.O. BOX 388, HARMONY, NC 28634

LOCATION I-77 NORTH, TR NC 901, TR DUTCHMAN ROAD, 1ST LOT ON LEFT

SUBDIVISION _____ BLOCK / SECTION _____ LOT _____ LOT AREA 15.5 ACRES SITE CLASS PS DESIGN FLOW 100 L.T.A.R. 0.30 GPD/FT²

Septic Tank: 1000 Gallons; STB 1012 Date 12-4-99
Pump Tank: _____ Gallons; PT _____ Date _____
Pump Make: _____ Model _____ Serial No. _____
Nitrification Field: No Fields 1 Square Feet 360 Linear Feet 120
No Lines ONE Trench Width 36" Max Trench Bottom Depth 36" Gravel Depth 12"

☑ New System ☐ Repair System Type: I (II) III. IV. V. VI
System Description: CONVENTIONAL GRAVITY
Repair System Description: CONVENTIONAL GRAVITY
Maintenance Agreement Required: ☐ Yes ☐ No
☑ Slab ☐ Crawl Space ☐ Basement w/plumbing ☐ Basement wo/plumbing

☐ House/Mod. Home No. Bedrooms —
☐ Mobile Home No. Bathrooms 1
☑ Business No. Employees 3
☐ Other WELDING SHOP


Water Supply:
☐ Individual
☑ Public
☐ Community

Comments./Conditions:

Comments./Conditions: SEPTIC TANK W/ RISERS AND MARKER INSTALLED USING "POLYLOK" FILTER

SCALE: 1" = 40'

INITIAL SITE SKETCH

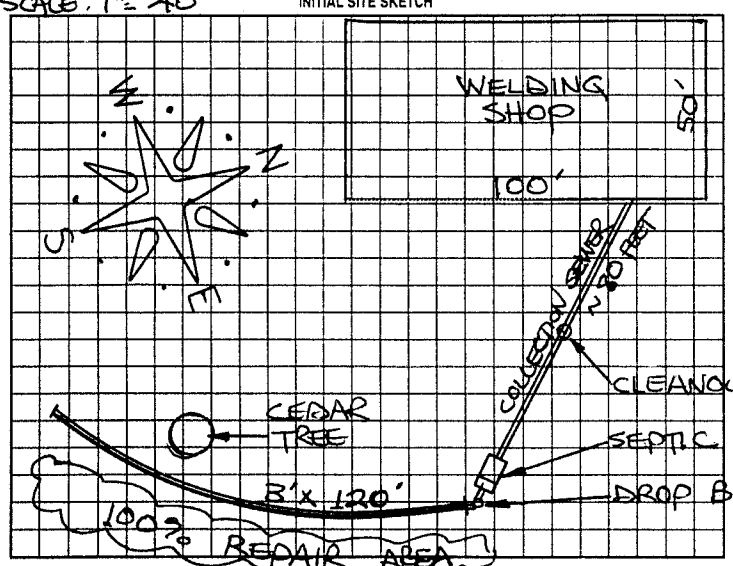

AS BUILT SKETCH

SYSTEM INSTALLED ACCORDING TO INITIAL SITE SKETCH

Permit can be suspended or revoked if any false information is supplied toward securing the permit/any unauthorized changes are made to the site/any unauthorized changes are made in the installation of the system. Improvement Permit with plat valid without expiration. Improvement Permit with site plan valid for sixty months. Authorization to Construct is valid for a period equal to that of Improvement Permit – not to exceed sixty months.

Signed: Tony [illegible] date 11-10-99 Installed by: BRENT GALLIHER

Improvement Permit by: STEVE HEDRICK date 11-3-99 Operation Permit by: STEVE HEDRICK date 3-31-00

Authorization to Construct by: STEVE HEDRICK date 11-3-99 Existing System Inspection by: _____ date _____

HEALTH DEPT COPY: WHITE OWNER COPY (FINAL): YELLOW OWNER COPY (INITIAL): PINK