THIS PERMIT REPLACES PREVIOUS ISSUED 12-11-2008

IREDELL COUNTY HEALTH DEPARTMENT - *ENVIRONMENTAL HEALTH* ☐ STATESVILLE OFFICE 704-878-5305 ☐ MOORESVILLE OFFICE 704-664-5281

IMPROVEMENT PERMIT / AUTHORIZATION TO CONSTRUCT @/ OPERATION PERMIT @/ EXISTING SYSTEM INSPECTION

PERMIT # 140876 PIN # 4871-05-3826 DATE SEPTEMBER 19, 2011

OWNER CHARLES DIXON APPLICANT: PHONE: Home/Cell # 704-872-5019 Business # 704-252-2840

SITE ADDRESS 180 NEBO ROAD, HARMONY, NC OWNER / APPLICANT ADDRESS

SITE DIRECTIONS US 21 NORTH, TL NC 901 TR NEBO ROAD, TR 1ST DRIVEWAY THROUGH WOODS ~900' BACK

SUBDIVISION BLOCK / SECTION LOT # 2 LOT AREA 9.434 Acres DESIGN FLOW 360 L.T.A.R. 0.20 GPD/FT²

Septic Tank 1000 Gallons: STB [illegible] 760 Date 10/23/11

Pump Tank Gallons: P T

Pump Make Model Serial #

No. Nitrification Fields: 1 No. Lines 4 Linear Feet 450

Trench Width 36" Max. Trench Bottom Depth 24" Gravel Depth N/A

☑ New System ☐ Repair ☐ Expansion System Type I II III IV V VI

System Description: 25% REDUCTION, GRAVITY

Repair System Description: 25% REDUCTION, PUMP

Maintenance Agreement Required ☐ YES ☑ NO

☑ GRAVITY ☐ PRESSURE

☑ Residence No. Bedrooms 3

☐ Business No. Persons

☐ Other No. Employees


☐ Slab ☐ Crawl Space

☑ Basement w/plumbing ☐ Basement w/o plumbing


Water Supply: ☐ Private ☑ Public ☐ Community

Comments / Conditions: ① INSTALL 25% REDUCTION SYSTEM ON CONTOUR AS SHOWN USING SERIAL DISTRIBUTION ② INSTALL TRENCHES NO DEEPER THAN 24". ③ CONTACT HEALTH DEPARTMENT TO CHECK BASEMENT ELEVATION AFTER EXCAVATION & PRIOR TO INSTALLING SYSTEM. ④ SCOUR TRENCH SIDEWALLS WHERE SMEARING OCCURS

INITIAL SITE SKETCH

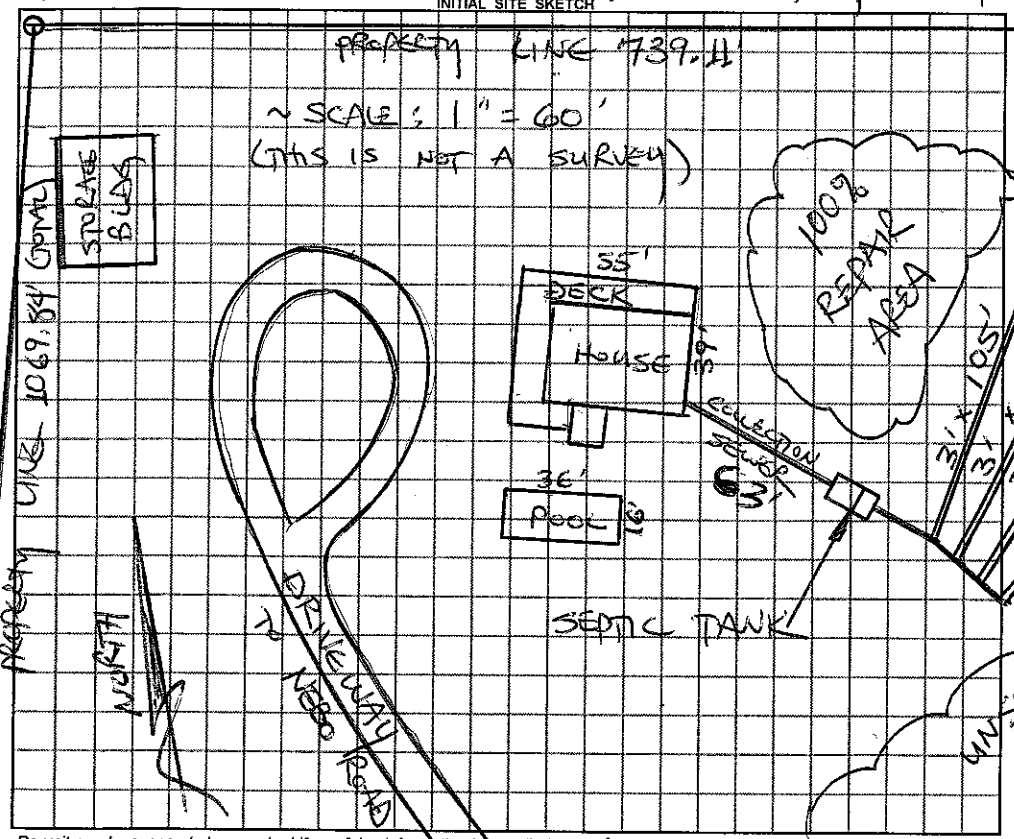

AS BUILT SKETCH

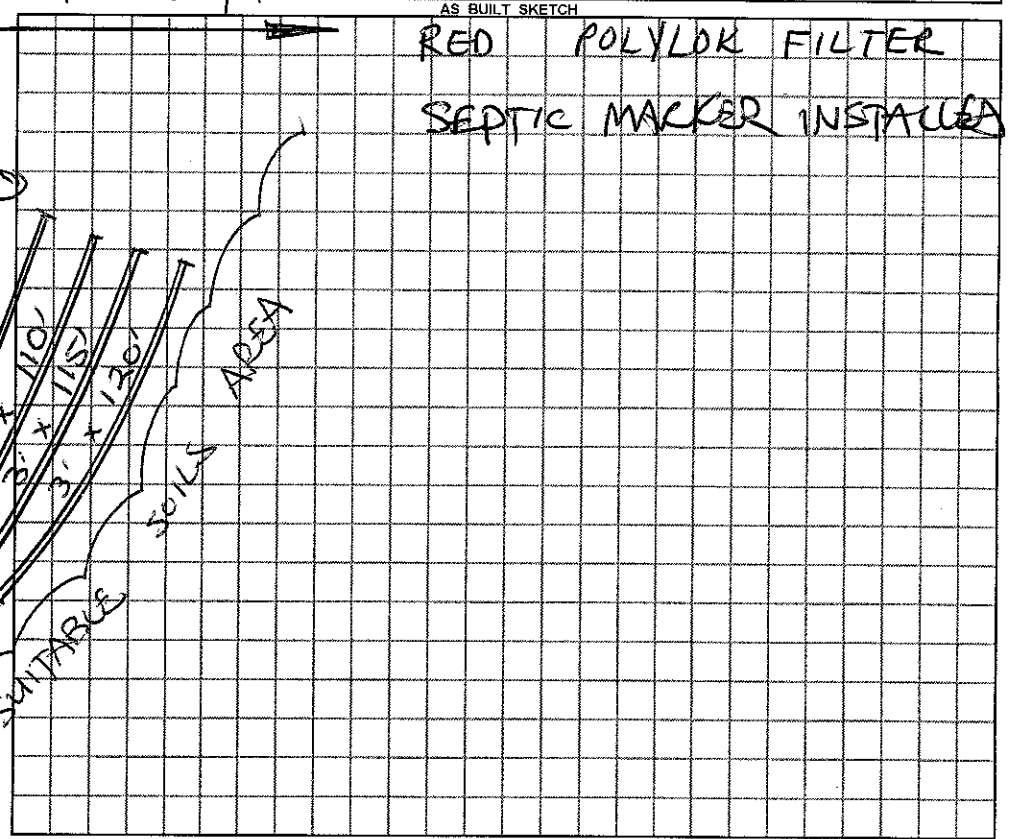

Permit can be suspended or revoked if any false information is supplied toward securing the permit / any unauthorized changes are made to the site / any unauthorized changes are made in the installation of the system.

☐ ***IMPROVEMENT PERMIT*** with plat valid without expiration. ☑ ***IMPROVEMENT PERMIT*** with ~~plat valid without expiration.~~ site plan valid 60 mo. ☐ ***AUTHORIZATION TO CONSTRUCT*** valid for period equal to IMPROVEMENT PERMIT--not to exceed 60 mo.

Owner / Applicant Signature: Charles E. Dixon 9-23-11 Date 9-23-2011

IMPROVEMENT PERMIT by: STEVE HEDRICK REHS Date 9-19-2011

AUTHORIZATION TO CONSTRUCT by: STEVE HEDRICK REHS Date 9-19-2011

YOU SHOULD CONTACT A LOCATOR SERVICE PRIOR TO ANY EXCAVATION

Installed by: BRIAN McDANIEL

OPERATION PERMIT by: STEVE HEDRICK REHS Date 3-23-12

Existing System Inspected by: REHS Date

White Copy – Environmental Health YELLOW COPY (Final) Owner / Applicant PINK COPY (Initial) Owner / Applicant