IREDELL COUNTY HEALTH DEPARTMENT

STATESVILLE 704-878-5305 (c) MOORESVILLE 704-664-5281

IMPROVEMENT PERMIT / AUTHORIZATION TO CONSTRUCT / OPERATION PERMIT / EXISTING SYSTEM INSPECTION

PERMIT# 135335 PIN# 4871069240 DATE 5-17-06

OWNER OR APPLICANT Piedmont Construction Company PHONE: Business 704 736 4335 Home

ADDRESS McMahon Farm Lane

LOCATION Hwy 21 left Hwy 901, left McMahon Farm Ln. property at end

SUBDIVISION n/a BLOCK / SECTION LOT 10 n/a LOT AREA 1.0 Ac SITE CLASS. PS DESIGN FLOW 360 L.T.A.R. .3

Septic Tank: 1000 Gallons; STB 760 Date 1-20-06
Pump Tank: Gallons; PT Date
Pump Make: Model Serial No.
Nitrification Field: No Fields 1 Square Feet 1200 Linear Feet 30
No Lines 6 Trench Width 36" Max Trench Bottom Depth 36"

☒ New System ☐ Repair ☐ Expansion System Type: I (II) III IV V VI
System Description: 25% Reduction
Repair System Description: 25% Pump Reduction
Maintenance Agreement Required: ☐ Yes ☒ No

☒ House/Mod. Home No. Bedrooms 3
☐ Mobile Home No. Persons
☐ Business No. Employees
☐ Other


Water Supply: ☒ Individual ☐ Public ☐ Community

Gravel Depth n/a ☒ Gravity ☐ Pressure ☐ Slab ☒ Crawl Space ☐ Basement w/plumbing ☐ Basement wo/plumbing

Comments:/Conditions: 208.68

Repair Area

INITIAL SITE SKETCH

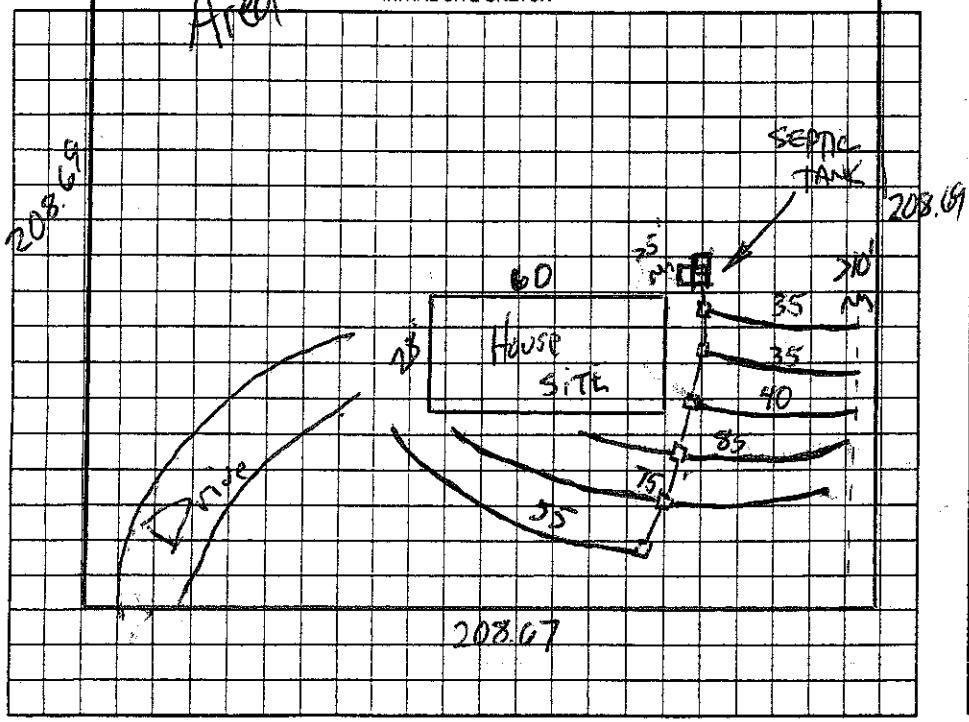

Comments:/Conditions: SEPTIC TANK WITH MARKER INSTALLED USING "RED POLYLOK" FILTER

AS BUILT SKETCH

SYSTEM INSTALLED ACCORDING TO INITIAL SITE SKETCH

Permit can be suspended or revoked if any false information is supplied toward securing the permit/any unauthorized changes are made to the site/any unauthorized changes are made in the installation of the system. Improvement Permit with plat valid without expiration. ☐ Improvement Permit with site plan valid for sixty months ☐ Authorization to Construct is valid for a period equal to that of Improvement Permit – not to exceed sixty months.

Signed: date 5/17/06 Installed by: ABEE GRADING

Improvement Permit by: James Stevens date 5-17-06 Operation Permit by: STEVE HENDRICK date 5-19-06

Authorization to Construct by: James Stevens date 5-17-06 Existing System Inspection by: date

HEALTH DEPT. COPY: WHITE OWNER COPY (FINAL): YELLOW OWNER COPY (INITIAL): PINK