IREDELL COUNTY HEALTH DEPARTMENT

STATESVILLE 704-878-5305 MOORESVILLE 704-664-5281

IMPROVEMENT PERMIT / AUTHORIZATION TO CONSTRUCT / OPERATION PERMIT / EXISTING SYSTEM INSPECTION

PERMIT# 073415 PIN# 4871 07 2309 DATE 7-25-98

OWNER OR CONTRACTOR HARVEY L. DALTON PHONE: Business Home 871-2318

ADDRESS P.O. BOX 266 HARMONY, NC 28634

LOCATION I-77 N, TR NC 901, TL NEBO ROAD, TR KIMMON ROAD, 7th LOT ON LEFT

SUBDIVISION KIMMON ESTATE BLOCK / SECTION LOT 7 LOT AREA 0.788 ACRE SITE CLASS. PS DESIGN FLOW 360 L.T.A.R.

Septic Tank: 1000 Gallons; STB 1012 Date 8-16-99
Pump Tank: Gallons; PT Date
Pump Make: Model Serial No.
Nitrification Field: No Fields 1 Square Feet EQ. TO 1200 Linear Feet 300
No Lines FIVE Trench Width 36" Max Trench Bottom Depth 36"

☑ New System ☐ Repair System Type: I, II, III, IV, V, VI
System Description: 25% REDUCTION-GRAVITY
Repair System Description: 25% REDUCTION-PUMP
Maintenance Agreement Required: ☐ Yes ☑ No
~~Gravel~~ Depth SAND 6" ☐ Slab ☑ Crawl Space ☐ Basement w/plumbing ☐ Basement wo/plumbing


☐ House/Mod. Home No. Bedrooms 3
☑ Mobile Home No. Bathrooms 2
☐ Business No. Employees
☐ Other

Water Supply: ☐ Individual ☑ Public ☐ Community

Comments/Conditions: INSTALL 25% REDUCTION SYSTEM ON CONTOUR AS FLAGGED (USING 50 CHAMBERS OR 30 HAS SECTIONS) ③ INSTALL SURFACE DIVERSION DITCH ON LOT AS SHOWN

Comments/Conditions: SEPTIC TANK WITH RISERS AND MARKER INSTALLED USING "POLYLOK" FILTER
SURFACE DIVERSION DITCH REMAINS TO BE INSTALLED
8-18-99 RSH

INITIAL SITE SKETCH SCALE: 1" = 50'

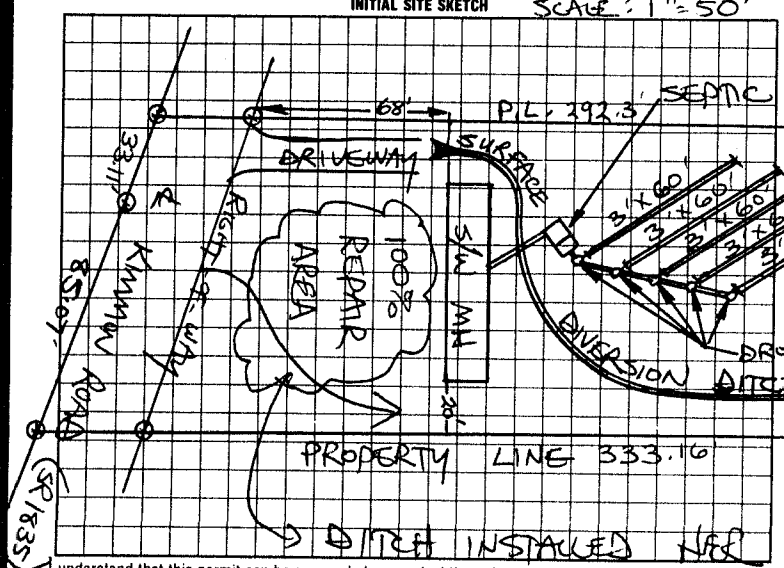

AS BUILT SKETCH

SYSTEM INSTALLED ACCORDING TO INITIAL SITE SKETCH

I understand that this permit can be suspended or revoked if any false information is supplied toward securing the permit/any unauthorized changes are made to the site/any unauthorized changes are made in the installation of the system. Improvement Permit with plat valid without expiration. Improvement Permit with site plan valid for sixty months. Authorization to Construct is valid for a period equal to that of Improvement Permit – not to exceed sixty months.

Signed: _____ date _____

Improvement Permit by: STEVE HEDRICK date 7-25-98

Authorization to Construct by: STEVE HEDRICK date 7-25-98

Installed by: TOMMY FRYE

Operation Permit by: STEVE HEDRICK date 8-18-99

Existing System Inspection by: _____ date _____

HEALTH DEPT. COPY: WHITE INSPECTION COPY (FINAL): GREEN OWNER COPY (FINAL): YELLOW INSPECTION COPY (INITIAL): PINK OWNER COPY (INITIAL): GOLD