IREDELL COUNTY HEALTH DEPARTMENT

Statesville Office (704) 878-5305 Mooresville Office (704) 660-3825 PERMIT # 223963

IMPROVEMENT PERMIT / AUTHORIZATION TO CONSTRUCT / OPERATION PERMIT / EXISTING SYSTEM

PIN # 4871-08-3935.271

APPLICANT: Tim W. Holthouser APPLICANT ADDRESS: 587 Jane Sowers Rd. Statesville, NC

SITE ADDRESS: 271 Kimmon Rd. Harmony, NC PHONE: 704-880-7506 ALT. PHONE:

SITE DIRECTIONS: 77N → Exit 90I E → Lon Nebo Rd → Lon Kimmon Rd → Lot on Right

SUBDIVISION: — SECTION: — LOT # — LOT AREA: 35.15 acres DESIGN FLOW: 360 GPD L.T.A.R.: 0.275


Septic Tank	1000	(gal)	STB	1012	Date	1-25-16	☒ New System	☐ Repair	☐ Expansion	System Type: I II (III) IV V VI	
Pump Tank	—	(gal)	PT	—	Date	—	System Description:	25% Reduction			
Pump Make	—	Model	—		Serial #	—	Repair System Description:	25% Reduction			
# Nitrification Fields	1	# Lines	3		Linear Ft:	330'	Maintenance Agreement Required:	☐ YES	☒ NO		
Trench Width	36"	Min. Trench Bottom Depth	30-36" Drip rule		Gravel Depth	—		☒ GRAVITY	☐ PRESSURE		

☒ Residence	No. Bedrooms	3	Water Supply		
☐ Business	No. Persons	6	☒ Private Existing		
☐ Other	No. Employees	—	☐ Public		
☐ Slab	☒ Crawl Space		☐ Community		
☐ Basement w/plumbing			☐ Basement w/o plumbing		


Comments / Conditions: Follow all N.C. Septic rules. Recommend pumping septic tank every 3-5 years. Strongly recommend fencing off septic area to prevent un hooved animals (cows, horses, etc) from damaging the drainfield.

* Driveway may be relocated around opposite side of house provided it does not encroach upon any sewage disposal system components. *
Shave down any surface berms to promote surface runoff.

INITIAL SITE SKETCH

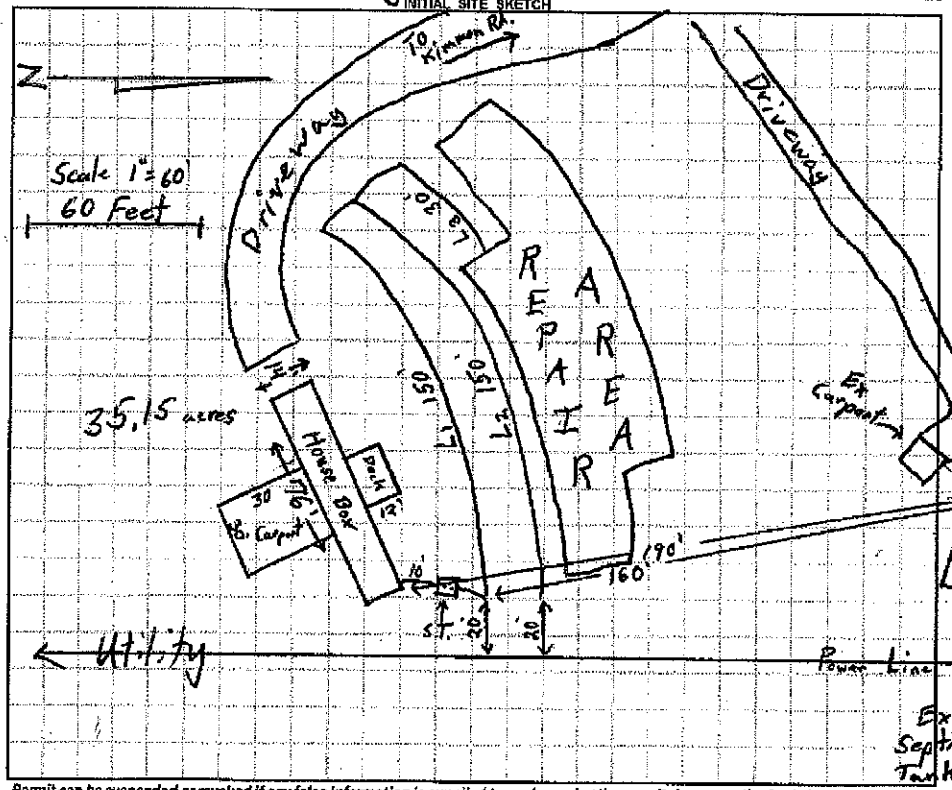

AS BUILT SKETCH

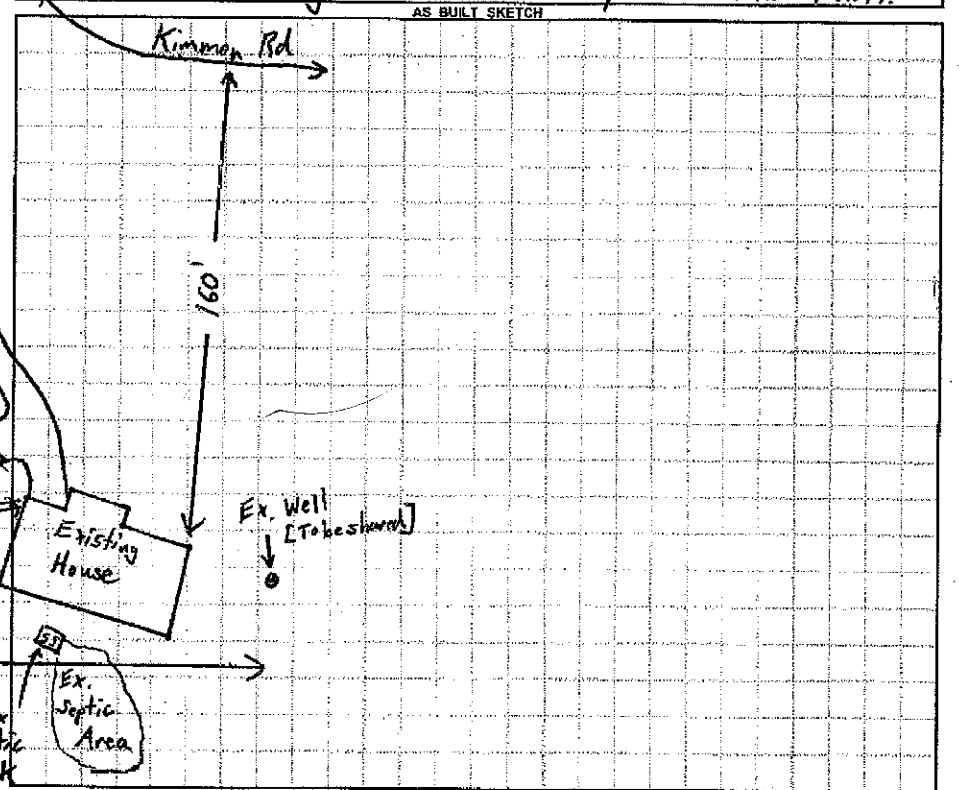

Permit can be suspended or revoked if any false information is supplied toward securing the permit / any unauthorized changes are made to the site / any unauthorized changes are made in the installation of the system. **CONTACT A LOCATOR SERVICE PRIOR TO ANY EXCAVATION**

☐ **IMPROVEMENT PERMIT** *with plat valid without expiration.* ☒ **IMPROVEMENT PERMIT** *with site plan valid for 60 mos.* ☒ **AUTHORIZATION TO CONSTRUCT** *valid for period equal to IMPROVEMENT PERMIT--not to exceed 60 mo.*

Owner / Applicant Signature: Tim Holthouser Date: 2-13-17 Installed by: Steve Jordon

IMPROVEMENT PERMIT by: Tom Shuck Date: 2-13-17 OPERATION PERMIT by: Marian Tatum Date: 2/27/17

AUTHORIZATION TO CONSTRUCT by: Tom Shuck Date: 2-13-17 Existing System Inspected by: — Date: —

Health Dept. Copy - WHITE Applicant (Final Approval) - YELLOW Applicant (Conditional Approval) - PINK