11:30

IREDELL COUNTY HEALTH DEPARTMENT - *ENVIRONMENTAL HEALTH* ☒ STATESVILLE OFFICE 704-878-5305 ☐ MOORESVILLE OFFICE 704-664-5281

IMPROVEMENT PERMIT / AUTHORIZATION TO CONSTRUCT / OPERATION PERMIT / EXISTING SYSTEM INSPECTION

PERMIT # 170444 PIN # 4871-19-6944 DATE 2-16-12

OWNER David Holmes APPLICANT: America's Home Place PHONE: Home/Cell # 704-746-7094 Business #

SITE ADDRESS 179 Kimmon Rd OWNER / APPLICANT ADDRESS same

SITE DIRECTIONS 77N, (R) 901, go 25 miles; (L) Nebo Rd, (L) Kimmon, site ½ mi on right

SUBDIVISION n/a BLOCK / SECTION n/a LOT # n/a LOT AREA 12.688 DESIGN FLOW 360 L.T.A.R. 3

Septic Tank 1000 Gallons: STB 1012 Date 10-14-11
Pump Tank ____ Gallons: P T ____ Date ____
Pump Make ____ Model ____ Serial # ____
No. Nitrification Fields: 1 No. Lines 3 Linear Feet 300
Trench Width 36" Max. Trench Bottom Depth 36" Gravel Depth n/a


☒ New System ☐ Repair ☐ Expansion System Type I II (III) IV V VI
System Description: 25% Reduction - Gravity
Repair System Description: 25% Reduction - Gravity
Maintenance Agreement Required ☐ YES ☒ NO
☒ GRAVITY ☐ PRESSURE

☒ Residence No. Bedrooms 3
☐ Business No. Persons ____
☐ Other No. Employees ____
☐ Slab ☒ Crawl Space
☐ Basement w/plumbing ☐ Basement w/o plumbing

Water Supply
☒ Private
☐ Public
☐ Community

Comments / Conditions

INITIAL SITE SKETCH

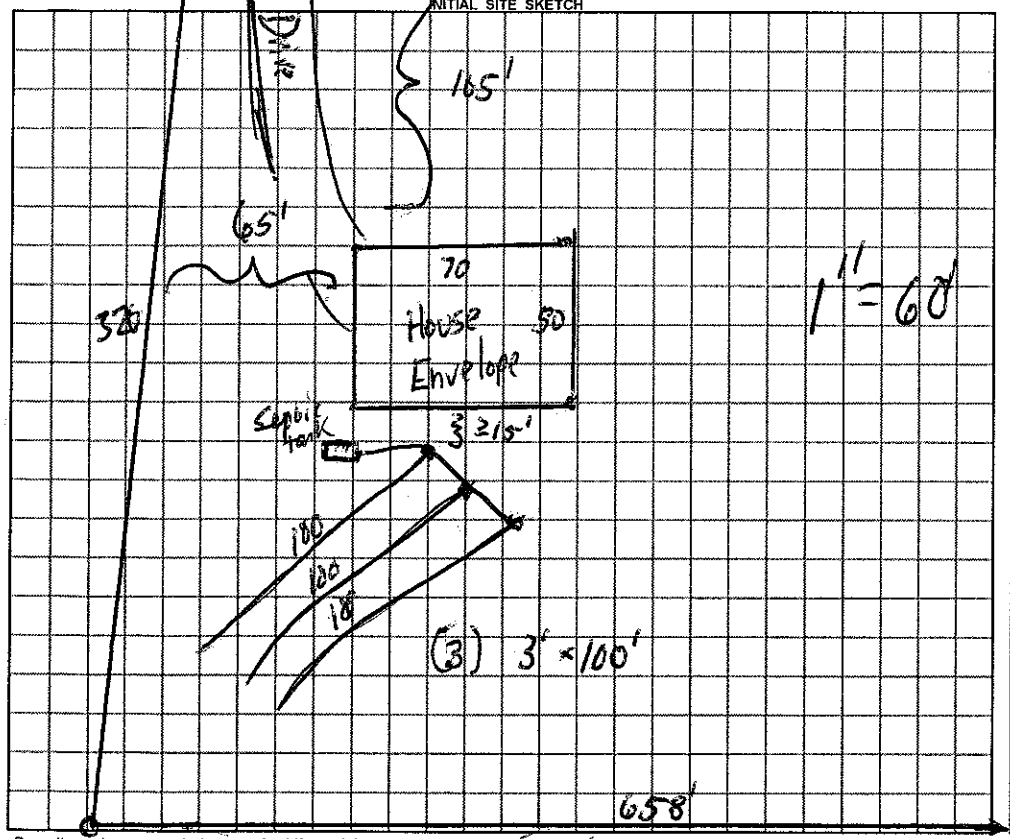

AS BUILT SKETCH

Permit can be suspended or revoked if any false information is supplied toward securing the permit / any unauthorized changes are made to the site / any unauthorized changes are made in the installation of the system.

☐ ***IMPROVEMENT PERMIT*** with plat valid without expiration. ☒ ***IMPROVEMENT PERMIT*** with plat ~~valid without expiration~~ site plan valid 60 mo. ☒ ***AUTHORIZATION TO CONSTRUCT*** valid for period equal to IMPROVEMENT PERMIT--not to exceed 60 mo.

Owner / Applicant Signature: [signature] Date 2/28/12 Installed by: Groundbreakers

IMPROVEMENT PERMIT by: [signature] REHS Date 2-16-12 OPERATION PERMIT by: [signature] REHS Date 4-17-12

AUTHORIZATION TO CONSTRUCT by: [signature] REHS Date 2-16-12 Existing System Inspected by: REHS Date

YOU SHOULD CONTACT A LOCATOR SERVICE PRIOR TO ANY EXCAVATION

White Copy – Environmental Health YELLOW COPY (Final) Owner / Applicant PINK COPY (Initial) Owner / Applicant